

MISSISSIPPI DEPARTMENT OF NATURAL RESOURCES

Bureau of Land and Water Resources

Southport Mall

P.O. Box 10631

Jackson, Mississippi 39209

WATER WELL DRILLERS LOG

COASTAL DRILLING & SERVICE CO.

Harrison
H 2264
5-26-84

5/26/84 19
date well completed

RT. 11, BOX 81
firm name

Harrison
county well located

LANDOWNER: Charles Sumner
Bouyou Cemetery Rd
Southport Rd
(mailing address)

WELL LOCATION:
sec. 17 T. 6 N. R. 10 E. S. W.
Southport
(distance) (direction) (nearest town)

WELL PURPOSE: home
(home, irrigation, municipal, industrial)

WELL COMPLETION DATA:
(1) diameter (inches) 4" x 2"
(2) total depth (feet) 325
(3) static water level (feet) 15 below/above top of ground.
(4) casing PVC, 310, (material) (depth)
4" x 2" (size) If telescope see back.
(5) screen 15', 310 (length) (depth to top)
2" PVC (size) (material)
(6) pump 2, 28-23 (HP) (yield gpm)
E.C. (type power)
(7) electric log No (yes or no)
(organization running log)
(8) how well bottom plugged 2" back
was later 19-B

description of formations encountered	from	to
top soil	1	5
red clay	5	25
sea or sand	25	40
soft blue clay	40	150
hard blue clay	150	240
course white sand	240	260
soft blue clay	260	305
fine water sand	305	315
good water sand	315	325

DRILLERS REMARKS:

RECEIVED
JUL 22 1985

Department of Natural Resources
Bureau of Land & Water Resources

DRILLERS REMARKS:

If well telescopes please sketch and show depths.


GROUND LEVEL

160' 4" pvc casing

165' 2" pvc casing

15' 2" pvc screen

2" back wash valve

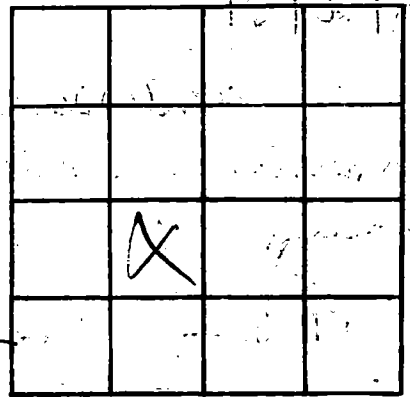

SECTION _____

Please indicate well location X.

ADDITIONAL INFORMATION

Lined area for additional information.

If more than one screen, show locations of each on sketch.