

MISSISSIPPI DEPARTMENT OF NATURAL RESOURCES

Bureau of Land and Water Resources

Southport Mall

P.O. Box 10631

Jackson, Mississippi 39209

WATER WELL DRILLERS LOG

COASTAL DRILLING & SERVICE CORPORATION

Harrison
2265
6-15-84

6/15/84 19
date well completed

RT. 44, BOX 81

county well located

LANDOWNER: James Donnell
Three Rivers Estates
Mulletport, MS
(mailing address)

WELL LOCATION:
sec 31 T. 6 N. R. 10 E
S W
Mulletport miles of (distance) (direction) (nearest town)

WELL PURPOSE: HOME
(home, irrigation, municipal, industrial)

WELL COMPLETION DATA:

(1) diameter (inches) 490 2"
(2) total depth (feet) 490
(3) static water level (feet) 10 below above top of ground.
(4) casing PVC, 480, (material) (depth)
(size) if telescope see back.
(5) screen 10, 480 (length) (depth to top)
2" PVC (size) (material)
(6) pump 1, 489 (HP) (yield gpm)
E/C. (type power)
(7) electric log NO (yes or no)
(organization running log)
(8) how well bottom plugged 2' back wash valve 17-B

description of formations encountered	from	to
top soil	1	3
old clay	3	20
sugar sand	20	40
soft blue clay	40	160
hard blue clay	160	290
course white sand	290	330
hard blue clay	330	470
fine water sand	470	480
good water sand	480	490


RECEIVED
JUL 22 1985

DRILLERS REMARKS:

Department of Natural Resources
Bureau of Land & Water Resources

If well telescopes please sketch and show depths.

GROUND LEVEL

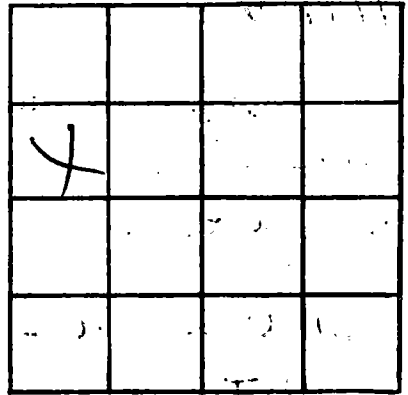

SECTION _____

Please indicate well location X.

ADDITIONAL INFORMATION

If more than one screen, show locations of each on sketch.