

MISSISSIPPI DEPARTMENT OF NATURAL RESOURCES

Bureau of Land and Water Resources

Southport Mall

P.O. Box 10631

Jackson, Mississippi 39209

WATER WELL DRILLERS LOG

DRILLING & SERVICE CO.

Harrison
H 2266
6-16-84

6/16/84
date well completed

DT 11, BOX 81
firm name

Harrison
county well located

BILOXI MS 39532

LANDOWNER: John Hampton

description of formations encountered

from to

North Biloxi

top soil

1 3

Biloxi, MS

red clay

3 20

(mailing address)

sugar sand

20 40

WELL LOCATION:

hard blue clay

40 210

sec. 14 T. 6 N. R. 10 E. S. W.

soft blue clay

210 360

Biloxi miles of (distance) 10 (direction) of (nearest town)

course white sand

360 390

WELL PURPOSE: home
(home, irrigation, municipal, industrial)

black clay

390 415

WELL COMPLETION DATA:

fine water sand

415 425

(1) diameter (inches) 2"

good water sand

425 435

(2) total depth (feet) 435'

(3) static water level (feet) 10 below above top of ground.

(4) casing PVC, 425'
(material) (depth)

(size) if telescope see back.

(5) screen 1.0', 425'
(length) (depth to top)

2", PVC
(size) (material)

(6) pump 1, 189
(HP) (yield gpm)


ELC
(type power)

(7) electric log No
(yes or no)

(organization running log)

(8) how well bottom plugged 2" back
wash valve 19-B

DRILLERS REMARKS:

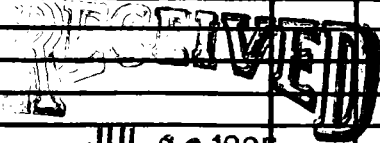

JUL 22 1985

Department of Natural Resources
Bureau of Land & Water Resources

If well telescopes please sketch and show depths.

GROUND LEVEL

			X

SECTION _____

Please indicate well location X.

ADDITIONAL INFORMATION

If more than one screen, show locations of each on sketch.