

MISSISSIPPI DEPARTMENT OF NATURAL RESOURCES

Bureau of Land and Water Resources

Southport Mall

P.O. Box 10631

Jackson, Mississippi 39209

WATER WELL DRILLERS LOG

COASTAL DRILLING & SERVICE CO.

ROUTE 1 BOX 018

HARRISON county well located

BILOXI, MISS. 39532

Harrison
H 2268
7-3-84

7/3/84
date well completed 19

LANDOWNER: Cynthia Beckman

Old woodmarket Rd

Biloxi, miss
(mailing address)

WELL LOCATION:

sec. 3 T. 6 N R. 10 E
S W

WOODMARKET

(distance) (direction) (nearest town)

WELL PURPOSE:

(home, irrigation, municipal, industrial)

WELL COMPLETION DATA:

- (1) diameter (inches) 2'
- (2) total depth (feet) 500
- (3) static water level (feet) 35 below above top of ground

(4) casing PVC 490
(material) (depth)

(size) if telescope see back.

(5) screen 10' 498
(length) (depth to top)

2' PVC
(size) (material)

(6) pump 1 28 @
(HP) (yield gpm)

4C
(type power)

(7) electric log NO
(yes or no)

(organization running log)

(8) how well bottom plugged 2' back-
wash valve 19-B

DRILLERS REMARKS:


description of formations encountered	from to	
top soil	1	3
red clay	3	20
course white sand	20	90
sugar sand	90	130
soft blue clay	130	330
fine water sand	330	365
hard blue clay	365	450
fine water sand	450	490
good water sand	490	500

RECEIVED
JUL 22 1985

Department of Natural Resources
Bureau of Land & Water Resources

If well telescopes please sketch and show depths.

GROUND LEVEL

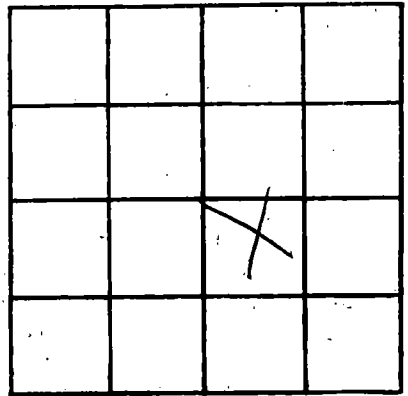

SECTION _____

Please indicate well location X.

ADDITIONAL INFORMATION

Lined area for additional information.

If more than one screen, show locations of each on sketch.