

MISSISSIPPI DEPARTMENT OF NATURAL RESOURCES

Bureau of Land and Water Resources

Southport Mall

P.O. Box 10631

Jackson, Mississippi 39209

WATER WELL DRILLERS LOG

COASTAL DRILLING & SERVICE, CO.

Harrison
H 2270
7-27-84

7/22/84
date well completed

Rt. 411, Box 31

Madison county well located

LANDOWNER: Bill Shank
103 Buffalo Jony Beach
Biloxi, ms
(mailing address)

WELL LOCATION:
sec. 25 T. 6 N. R. 9 E. W. 10
Biloxi miles of (distance) (direction) of (nearest town)

WELL PURPOSE: home
(home, irrigation, municipal, industrial)

WELL COMPLETION DATA:
(1) diameter (inches) 4" x 2"
(2) total depth (feet) 540'
(3) static water level (feet) 15 below above top of ground.
(4) casing PVC 525'
(material) (depth)
4" x 2" if telescope see back.
(size)
(5) screen 15' 525'
(length) (depth to top)
2" PVC
(size) (material)
(6) pump 1 FX
(HP) (yield gpm)
etc.
(type power)
(7) electric log NLO
(yes or no)

(organization running log)
(8) how well bottom plugged 2" back
washed with 19-B

DRILLERS REMARKS:

description of formations encountered	from	to
TOP SOIL	1	5
sugar sand	5	30
red clay	30	120
soft black clay	120	240
coarse white sand	240	260
hard blue clay	260	380
coarse white sand	380	400
red clay	400	460
soft blue clay	460	520
fine water sand	520	530
loose water sand	530	540

RECEIVED
JUL 22 1985

Department of Natural Resources
Bureau of Land & Water Resources

If well telescopes please sketch and show depths.

GROUND LEVEL


200' 4" pvc casing

340' 2" pvc casing

15' 2" pvc screen

2" backwash valve

If more than one screen, show locations of each on sketch.

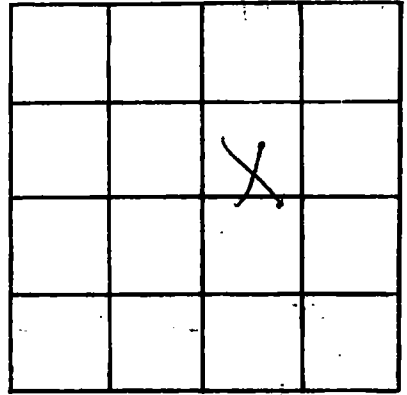

SECTION _____

Please indicate well location X.

ADDITIONAL INFORMATION

Multiple horizontal lines for additional information.