

MISSISSIPPI DEPARTMENT OF NATURAL RESOURCES

Bureau of Land and Water Resources

Southport Mall

P.O. Box 10631

Jackson, Mississippi 39209

WATER WELL DRILLERS LOG

COASTAL DRILLING & SERVICE CO.

HARRISON
H
2277

12/5/84

date well completed

19

RT. 11, BOX 21

Harrison county well located

LANDOWNER: Darlene Perry

BILOXI, MS 39532

description of formations encountered

from

to

RT. 1 BOX 49

top soil

1 10

Biloxi, MS

(mailing address)

sugar sand

10 35

red clay

35 160

hard blue clay

160 300

fine water sand

300 320

good water sand

320 330

WELL LOCATION:

sec. 7 T. 6 N. S

R. 10 E. W

Wool Market

(distance) (direction) of (nearest town)

WELL PURPOSE: HOME

(home, irrigation, municipal, industrial)

WELL COMPLETION DATA:

- (1) diameter (inches) 2"
- (2) total depth (feet) 330
- (3) static water level (feet) 10 below top of ground.

- (4) casing PVC, 320 (material) (depth)

(size) If telescope see back.

- (5) screen 10', 320 (length) (depth to top)

2" PVC (size) (material)

- (6) pump 1 (HP) 189 (yield gpm)

ELC (type power)

- (7) electric log No (yes or no)

(organization running log)

- (8) how well bottom plugged 2" back wash water 19-B

RECEIVED

AUG - 5 1985


DRILLERS REMARKS:

Department of Natural Resources
Bureau of Land & Water Resources

If well telescopes please sketch and show depths.

GROUND LEVEL

[Faint handwritten notes in the left margin, possibly describing well details or site conditions.]

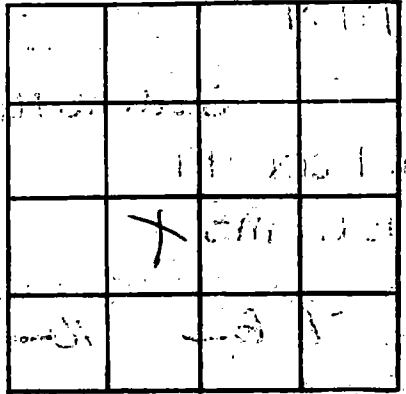

CROSS SECTION

Please indicate well location X.

ADDITIONAL INFORMATION

[A series of horizontal lines for recording additional information, with some faint handwritten notes.]

If more than one screen, show locations of each on sketch.