

MISSISSIPPI DEPARTMENT OF NATURAL RESOURCES

Bureau of Land and Water Resources

Southport Mall

P.O. Box 10631

Jackson, Mississippi 39209

WATER WELL DRILLERS LOG

COASTAL DRILLING & SERVICE CO.

HARRISON
H
2278

12/9/84

date well completed

RT. 11 BOX 01

BILOXI, MS 39532

county well located

LANDOWNER: Joan Boyne

1255 Hardy Court

Biloxi, MS

(mailing address)

WELL LOCATION:

sec. 25 T. 6 N S R. 10 E W

Biloxi

(distance) miles (direction) of (nearest town)

WELL PURPOSE: home

(home, irrigation, municipal, industrial)

WELL COMPLETION DATA:


- (1) diameter (inches) 2"
- (2) total depth (feet) 260
- (3) static water level (feet) 10 below top of ground.
- (4) casing PVC, 250 (material), (depth)
- (size) If telescope see back.
- (5) screen 10, 250 (length), (depth to top)
- 2", PVC (size), (material)
- (6) pump 1/2, 22 (HP), (yield gpm)
- etc. (type power)
- (7) electric log NO (yes or no)

(organization running log)

(8) how well bottom plugged 2" back wash valve 19-B

description of formations encountered	from	to
top soil	1	10
sugar sand	10	25
red clay	25	160
coarse white sand	160	170
hard blue clay	170	240
fine water sand	240	250
good water sand	250	260

DRILLERS REMARKS:

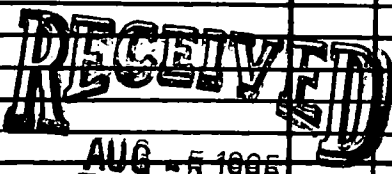

Department of Natural Resources
Bureau of Land & Water Resources

