

MISSISSIPPI DEPARTMENT OF NATURAL RESOURCES

Bureau of Land and Water Resources

Southport Mall

P.O. Box 10631

Jackson, Mississippi 39209

WATER WELL DRILLERS LOG  
COASTAL DRILLING & SERVICE CO.

HARRISON  
H  
2279

12/5/84  
date well completed

RT. 11 BOX 81

Harrison county well located

LANDOWNER: Virginia Ponder  
380 Cook Rd.  
Biloxi MS  
(mailing address)

Block MS 39532

description of formations encountered	from	to
top soil	1	10
berger sand	10	20
red clay	20	130
course white sand	130	140
hard blue clay	140	290
fine water sand	290	310
soft blue clay	310	440
fine water sand	440	450
good water sand	450	460

WELL LOCATION:  
sec. 15 T. 6 N. S. R. 10 E. W.  
Biloxi miles (distance) of (direction) of (nearest town)

WELL PURPOSE: home  
(home, irrigation, municipal, industrial)

WELL COMPLETION DATA:

(1) diameter (inches) 2"

(2) total depth (feet) 460

(3) static water level (feet) 10 below top of ground

(4) casing PVC, 450 (material) (depth)  
(size) if telescope see back.

(5) screen 10', 450 (length) (depth to top)  
2" PVC (size) (material)

(6) pump 1 (HP) 17 10 (yield gpm)  
Etc. (type power)

(7) electric log NO (yes or no)  
(organization running log)

(8) how well bottom plugged 2" back wash valve 19-B

RECEIVED


AUG 5 1985

DRILLERS REMARKS:

Department of Natural Resources  
Bureau of Land & Water Resources

If well telescopes please sketch and show depths.

GROUND LEVEL

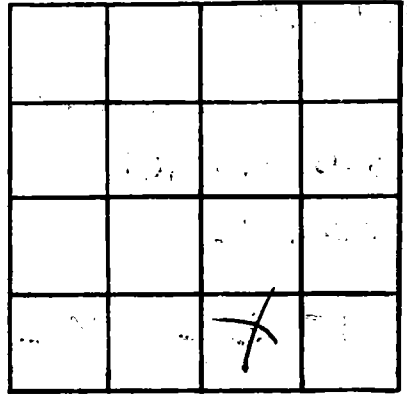

SECTION \_\_\_\_\_

Please indicate well location X.

ADDITIONAL INFORMATION

If more than one screen, show locations of each on sketch.