

MISSISSIPPI DEPARTMENT OF NATURAL RESOURCES

Bureau of Land and Water Resources

Southport Mall

P.O. Box 10631

Jackson, Mississippi 39209

WATER WELL DRILLERS LOG

COASTAL DRILLING & SERVICE Co.

Harrison
H 2280
9-14-84

L

9/14/84
date well completed 19

Rt. 10, Box 81

Harrison
county well located

LANDOWNER: Arnold Johnson
Hibark Rd
Saucier, MS
(mailing address)


description of formations encountered	from	to
top soil	1	5
silty sand	5	20
red clay	20	160
hard blue clay	160	220
silty sand	220	230
hard water sand	230	240

WELL LOCATION:
sec. 22 T. 6 N. R. 10 E. W. 5
Saucier miles of (distance) (direction) of (nearest town)

WELL PURPOSE: home
(home, irrigation, municipal, industrial)

WELL COMPLETION DATA:

- (1) diameter (inches) 2"
- (2) total depth (feet) 240
- (3) static water level (feet) 10 below above top of ground.
- (4) casing PVC, 230,
(material) (depth)
(size) if telescope see back.
- (5) screen 10', 230
(length) (depth to top)
2", PVC
(size) (material)
- (6) pump 1, 16-12
(HP) (yield gpm)
E/C
(type power)
- (7) electric log NO
(yes or no)
(organization running log)
- (8) how well bottom plugged 3" back
wash pipe, 19-3

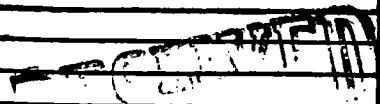

AUG 2 1985

DRILLERS REMARKS:

Department of Natural Resources
Bureau of Land and Water Resources

If well telescopes please sketch and show depths.

GROUND LEVEL

	X		

SECTION _____

Please indicate well location X.

ADDITIONAL INFORMATION

If more than one screen, show locations of each on sketch.