

MISSISSIPPI DEPARTMENT OF NATURAL RESOURCES

Bureau of Land and Water Resources

Southport Mall

P.O. Box 10631

Jackson, Mississippi 39209

WATER WELL DRILLERS LOG
COASTAL DRILLING & SERVICE CO.

Harrison
H 2282
9-12-84
9/12/84

date well completed 19

RT. 11, BOX 81
Harrison
BILBO, MS 39532

Harrison
county well located

LANDOWNER: Hannay, John
800 Colmore Rd
Gulfport, MS
(mailing address)

WELL LOCATION:
sec. 14 T 6 N R 10 E
S W
Gulfport
(distance) (direction) (nearest town)

WELL PURPOSE: home
(home, irrigation, municipal, industrial)

WELL COMPLETION DATA:

(1) diameter (inches) 4" x 2"

(2) total depth (feet) 540

(3) static water level (feet) 10 below above top of ground.

(4) casing PVC, 530,
(material) (depth)
4" x 2" if telescope see back.
(size)

(5) screen 10', 530
(length) (depth to top)
2", PVC
(size) (material)

(6) pump L, 7.10
(HP) (yield gpm)
Etc.
(type power)

(7) electric log NO
(yes or no)
(organization running log)

(8) how well bottom plugged 2" back
wash hole 19-0

description of formations encountered	from	to
topsoil	1	10
silty sand	10	20
red clay	20	180
soft blue clay	180	300
coarse white sand	300	340
hard blue clay	340	500
coarse white sand	500	520
fine water sand	520	530
good water sand	530	540

RECEIVED
AUG - 2 1985

Department of Natural Resources
Bureau of Land & Water Resources

DRILLERS REMARKS:

If well telescopes please sketch and show depths.


GROUND LEVEL

160' 4" PVC casing

380' 2" PVC casing

15' 2" PVC screen

2" backwash valve

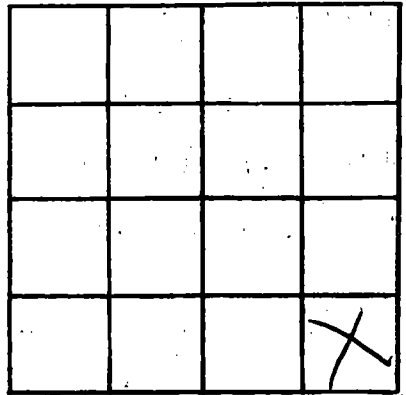

SECTION _____

Please indicate well location X.

ADDITIONAL INFORMATION

If more than one screen, show locations of each on sketch.