

MISSISSIPPI DEPARTMENT OF NATURAL RESOURCES

Bureau of Land and Water Resources

Southport Mall

P.O. Box 10631

Jackson, Mississippi 39209

WATER WELL DRILLERS LOG  
COASTAL DRILLING & SERVICE CO.

HARRISON  
H 2283  
1/9/85

1/9/85  
date well completed

ST. 11, BOX 81  
firm name

BILOXI, MS 39532

Harrison  
county well located

LANDOWNER: Med Hulse  
Hwy 15  
Biloxi, MS  
(mailing address)

WELL LOCATION:  
sec. 15 T. 6 N. R. 10 E.  
S W  
Biloxi miles \_\_\_\_\_ of \_\_\_\_\_  
(distance) (direction) (nearest town)

WELL PURPOSE: none  
(home, irrigation, municipal, industrial)

WELL COMPLETION DATA:  
(1) diameter (inches) 2"  
(2) total depth (feet) 430  
(3) static water level (feet) 10 below/above top of ground.  
(4) casing 2" (material) PVC (depth) 420.  
(size) If telescope see back.  
(5) screen 10 (length) 420 (depth to top).  
2" (size) PVC (material)  
(6) pump 1 (HP) 10 (yield gpm).  
FLC (type power)  
(7) electric log NO (yes or no)  
(organization running log)

(8) how well bottom plugged 2" back wash valve

DRILLERS REMARKS: 19-8

description of formations encountered	from	to
top soil	1	5
sets sand	5	15
soft blue clay	15	180
hard blue clay	180	340
red clay	340	410
fine water sand	410	420
coarse water sand	420	430


RECEIVED

AUG 27 1985

Department of Natural Resources  
Bureau of Land and Water Resources

If well telescopes please sketch and show depths.

GROUND LEVEL

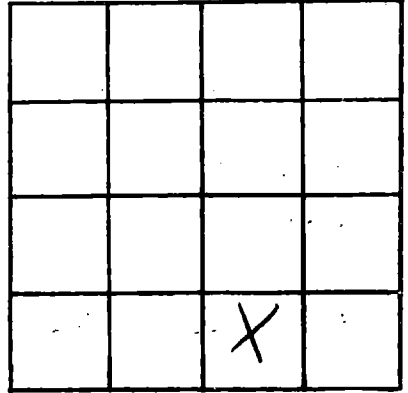

SECTION \_\_\_\_\_

Please indicate well location X.

**ADDITIONAL INFORMATION**

A series of 18 horizontal lines for entering additional information.

If more than one screen, show locations of each on sketch.