

MISSISSIPPI DEPARTMENT OF NATURAL RESOURCES

Bureau of Land and Water Resources

Southport Mall

P.O. Box 10631

Jackson, Mississippi 39209

WATER WELL DRILLERS LOG

COASTAL DRILLING & SERVICE CO.

Harrison  
H 2297  
2-3-85

2/3/85

date well completed

RT. 11, BOX 21 name

Harrison county well located

LANDOWNER: C. D. Roberts  
15521 Old River Loop  
Vandevaux, MS  
(mailing address)

WELL LOCATION:  
sec. 24 T. 6 N. R. 10 E. S. W.  
Vandevaux miles of (distance) (direction) of (nearest town)

WELL PURPOSE: home  
(home, irrigation, municipal, industrial)

WELL COMPLETION DATA:  
(1) diameter (inches) 220' 2'  
(2) total depth (feet) 280'  
(3) static water level (feet) 10 below top of ground  
(4) casing PVC, 210' (material) (depth)  
(size) if telescope see back.  
(5) screen 10' (length), 210' (depth to top)  
2" (size), PVC (material)  
(6) pump 1 (HP), 9 (yield gpm)  
Etc. (type power)  
(7) electric log NO (yes or no)  
(organization running log)  
(8) how well bottom plugged 2' back wash valve 19-3

description of formations encountered	from to	
	feet	feet
top soil	1	5
sugar sand	5	20
red clay	20	160
blue clay	160	200
fine water sand	200	210
good water sand	210	220


RECEIVED  
JUL 25 1985

Department of Natural Resources  
Bureau of Land & Water Resources

DRILLERS REMARKS:

If well telescopes please sketch and show depths.

GROUND LEVEL

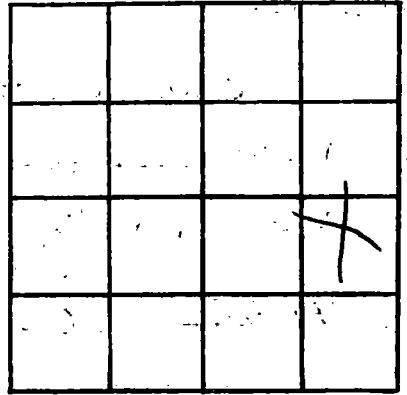

SECTION \_\_\_\_\_

Please indicate well location X.

ADDITIONAL INFORMATION

If more than one screen, show locations of each on sketch.