

MISSISSIPPI DEPARTMENT OF NATURAL RESOURCES

Bureau of Land and Water Resources

Southport Mall

P.O. Box 10631

Jackson, Mississippi 39209

**WATER WELL DRILLERS LOG**  
**COASTAL DRILLING & SERVICE CO.**

HARRISON  
H 2288  
3/25/85

3/25/85  
date well completed

Box 81  
P.O. Box 81

Harrison  
county well located

ELTON, MS 39532

LANDOWNER: Carlross Pedmon

Jordon rd.

Belton, MS  
(mailing address)

WELL LOCATION:

sec. 15 T. 6 N R. 10 E  
S W

Belton miles of (distance) (direction) of (nearest town)

WELL PURPOSE: home  
(home, irrigation, municipal, industrial)

WELL COMPLETION DATA:

(1) diameter (inches) 2"  
(2) total depth (feet) 300

(3) static water level (feet) 10 below above top of ground

(4) casing PVC 490  
(material) (depth)

(size) If telescope see back.

(5) screen 10 490  
(length) (depth to top)

2" PVC  
(size) (material)

(6) pump 1 9  
(HP) (yield gpm)

ELC  
(type power)

(7) electric log NO  
(yes or no)

(organization running log)

(8) how well bottom plugged 2" back  
wash valve 19-B

DRILLERS REMARKS:


description of formations encountered	from	to
top soil	1	5
sugar sand	5	10
red clay	10	180
soft blue clay	180	290
hard blue clay	290	395
red clay	395	480
fine water sand	480	490
hard water sand	490	500

**RECEIVED**  
MAR 27 1985

Department of Natural Resources  
Bureau of Land and Water Resources

If well telescopes please sketch and show depths.

GROUND LEVEL

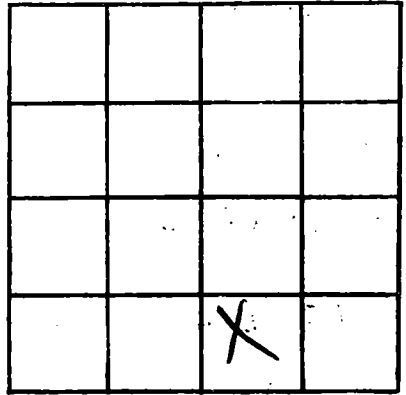

SECTION \_\_\_\_\_

Please indicate well location X.

ADDITIONAL INFORMATION

If more than one screen,  
show locations of each on sketch.