

HARRISON
 JACKSON
 H
 2292

MISSISSIPPI DEPARTMENT OF NATURAL RESOURCES
 Bureau of Land and Water Resources
 Southport Mall
 P.O. Box 10631

Jackson, Mississippi 39209
 WATER WELL DRILLERS LOG HARRISON

3-26-85 date well completed 19
 Cross Water Well Sew Inc. firm name
 Harrison county well located

LANDOWNER: F.W. Eldridge
 Rt 2 Box 268
 Bixoi, Miss 39532
 (mailing address)

WELL LOCATION:
 sec. 14 T 6 N R 10 E
 7 miles N of Bixoi
 (distance) (direction) (nearest town)

WELL PURPOSE: Home
 (home, irrigation, municipal, industrial)

- WELL COMPLETION DATA:
- (1) diameter (inches) 2"
 - (2) total depth (feet) 375'
 - (3) static water level (feet) 145' below top of ground.
 - (4) casing PVC 355' (material) (depth)
 - 2" If telescope see back.
 - (5) screen 20' 355' (length) (depth to top)
 - 2" PVC (size) (material)
 - (6) pump 2hp. (HP) (yield gpm)
 - Elect. (type power)
 - (7) electric log No (yes or no)
 - (organization running log)
 - (8) how well bottom plugged
 Rich Wash Valve

description of formations encountered	from	to
Top soil	0	3'
Red Clay	3'	20'
Coarse white sand	20'	65'
Clay - gravel	65'	86'
Blue Clay	170'	189'
Med. white sand	189'	200'
Blue Clay	200'	255'
Med. fipped sand	255'	269'
Blue Clay	269'	340'
Coarse sand	340'	345'
Blue Clay	345'	355'
Coarse gray sand	355'	375'


RECEIVED
 JUL 10 1985

Department of Natural Resources
 Bureau of Land & Water Resources

DRILLERS REMARKS:

If well telescopes please sketch and show depths.

GROUND LEVEL

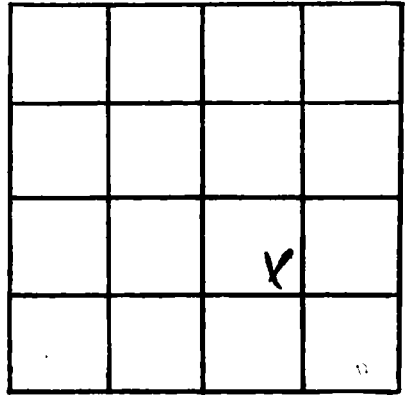

SECTION 14

Please indicate well location X.

ADDITIONAL INFORMATION

If more than one screen, show locations of each on sketch.