

MISSISSIPPI DEPARTMENT OF NATURAL RESOURCES

Bureau of Land and Water Resources

Southport Mall

P.O. Box 10631

Jackson, Mississippi 39209

WATER WELL DRILLERS LOG

HARRISON
H 2296

4/19/85
date well completed

19 Lyman Well Co.
firm name

Harrison
county well located

LANDOWNER: Bill Pennell
705 Gardendale Ave
Long Beach, MS 39560
(mailing address)

description of formations encountered

from to

white clay	0	120
gray clay	40	80
fine sand	80	100
gray clay	100	260
course sand	200	280

WELL LOCATION:

sec. 3 T 6 N R 10 E
S W
3 miles south of Woodman
(distance) (direction) (nearest town)

WELL PURPOSE: home
(home, irrigation, municipal, industrial)

WELL COMPLETION DATA:


- (1) diameter (inches) 2"
- (2) total depth (feet) 280'
- (3) static water level (feet) 12' ^{below} _{above} top of ground.
- (4) casing PVC, 270'
(material) (depth)
2" if telescope see back.
(size)
- (5) screen 10', 270'
(length) (depth to top)
2", PVC
(size) (material)
- (6) pump 1, 15
(HP) (yield gpm)
electric
(type power)
- (7) electric log No
(yes or no)
No
(organization running log)
- (8) how well bottom plugged sand
shark

RECEIVED
AUG 20 1985
Department of Natural Resources
Bureau of Land & Water Resources

DRILLERS REMARKS:

If well telescopes please sketch and show depths.

GROUND LEVEL

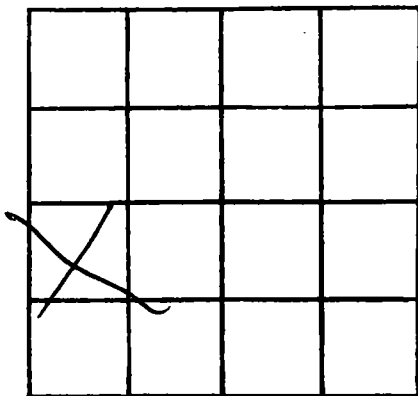

SECTION 3

Please indicate well location X.

ADDITIONAL INFORMATION

If more than one screen, show locations of each on sketch.