

MISSISSIPPI DEPARTMENT OF NATURAL RESOURCES

Bureau of Land and Water Resources

Southport Mall

P.O. Box 10631

Jackson, Mississippi 39209

WATER WELL DRILLERS LOG

Harrison
H 2297
5-15-85

5-15 1985 date well completed
McLell Well Works firm name
Harrison county well located

LANDOWNER: Tom Moore
3025 Doby Dr.
Pascagoula Ms.
(mailing address)

WELL LOCATION:
sec 36 T 6 N R 10 E
9.5 miles N of Biloxi
(distance) (direction) (nearest town)

WELL PURPOSE:
(home, irrigation, municipal, industrial)

WELL COMPLETION DATA:
(1) diameter (inches) 2"
(2) total depth (feet) 190'
(3) static water level (feet) 50' below top of ground.
(4) casing PVC Sch 40 180' (material) (depth)
(size) if telescope see back.
(5) screen 10' 180' (length) (depth to top)
2" Sol so 6 slot (size) (material)
(6) pump 1 (HP) 8 (yield gpm)
Elec (type power)
(7) electric log (yes or no)
(organization running log)
(8) how well bottom plugged SAND SHARK

description of formations encountered	from	to
Mud / Sand	0	20
Sand / Gravel	20	40
Sand / Gravel / Mud	40	60
Mud	60	100
Mud / Sand	100	120
Sand / Mud	120	140
Mud	140	160
Sand	160	190


RECEIVED
JUN 11 1985

Department of Natural Resources
Bureau of Land & Water Resources

DRILLERS REMARKS:

If well telescopes please sketch and show depths.

GROUND LEVEL

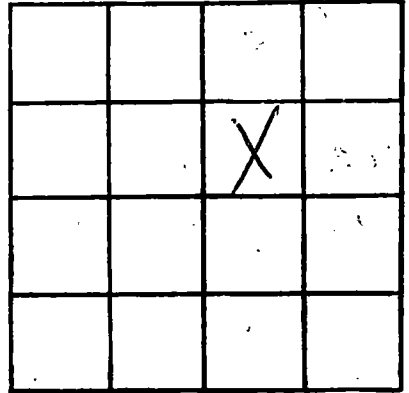

SECTION _____

Please indicate well location X.

ADDITIONAL INFORMATION

If more than one screen, show locations of each on sketch.