

MISSISSIPPI DEPARTMENT OF NATURAL RESOURCES

Bureau of Land and Water Resources

Southport Mall

P.O. Box 10631

Jackson, Mississippi 39209

WATER WELL DRILLERS LOG

HARRISON
H
2304

5-28-85 19 Coast Water Well Sew. Jackson
date well completed firm name county well located

LANDOWNER: Froy Tolsher
Rt 2 Box 578,
Biloxi, Miss 39532
(mailing address)

WELL LOCATION:
sec 34 T 6 S R 10 E
5 miles N Biloxi
(distance) (direction) (nearest town)

WELL PURPOSE: Home
(home, irrigation, municipal, industrial)

WELL COMPLETION DATA:

(1) diameter (inches) 2"

(2) total depth (feet) 465'

(3) static water level (feet) 125' below above top of ground.

(4) casing PVC 455'
(material) (depth)

2" if telescope see back.
(size)

(5) screen 10' 455'
(length) (depth to top)

2" PVC
(size) (material)

(6) pump — —
(HP) (yield gpm)

elect.
(type power)

(7) electric log No
(yes or no)

—
(organization running log)

(8) has well bottom plugged Back Wash Valve

description of formations encountered	from	to
<u>Top soil</u>	<u>0</u>	<u>2'</u>
<u>Red Clay</u>	<u>2'</u>	<u>22'</u>
<u>Rock</u>		<u>22'</u>
<u>Blue Clay</u>	<u>22'</u>	<u>97'</u>
<u>Red Med. sand</u>	<u>97'</u>	<u>120'</u>
<u>Blue Clay</u>	<u>120'</u>	<u>378'</u>
<u>Gray fine sand</u>	<u>378'</u>	<u>425'</u>
<u>Gray med sand</u>	<u>425'</u>	<u>420'</u>
<u>Gray coarse sand</u>	<u>420'</u>	<u>465'</u>
<u>3-2" Tail Pipe</u>		


RECEIVED
JUL 10 1985

Department of Natural Resources
Bureau of Land & Water Resources

DRILLERS REMARKS:

If well telescopes please sketch and show depths.

GROUND LEVEL

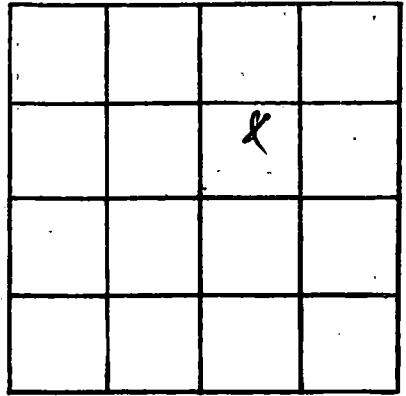

SECTION 34

Please indicate well location X.

ADDITIONAL INFORMATION

If more than one screen, show locations of each on sketch.