

MISSISSIPPI DEPARTMENT OF NATURAL RESOURCES

Bureau of Land and Water Resources

Southport Mall

P.O. Box 10631

Jackson, Mississippi 39209

WATER WELL DRILLERS LOG

HARRISON
H
2305

7-26

1985

McHill Pump & Well

Harrison

date well completed

firm name

county well located

LANDOWNER: Gordon Reach

P.O. Box 6607

Southport, Ms. 39501
(mailing address)

WELL LOCATION:

sec. 18 T. 6 N R. 10 E
6 miles NW of Woolmarket
(distance) (direction) (nearest town)

WELL PURPOSE:

(home, irrigation, municipal, industrial)

WELL COMPLETION DATA:

- (1) diameter (inches) 2"
- (2) total depth (feet) 400'
- (3) static water level (feet) 50' ^{below} top of ground.
- (4) casing Sch. 40 PVC, 390'
(material) (depth)
- (size) If telescope see back.
- (5) screen 10' 390'
(length) (depth to top)
- 2" Sch. 80 PVC 60ft
(size) (material)
- (6) pump 1 (HP) 7 (yield gpm)
- elec.
(type power)
- (7) electric log (yes or no)

(organization running log)

(8) how well bottom plugged SAND SEAL

description of formations encountered

from

to

Mud	0	20
Mud/Sand	20	60
Mud	60	80
Mud/Sand	80	100
Sand/Mud	100	120
Mud	120	320
Mud/Sand	320	340
Sand	340	400


RECEIVED

AUG 20 1985

DRILLERS REMARKS:

If well telescopes please sketch and show depths.

GROUND LEVEL

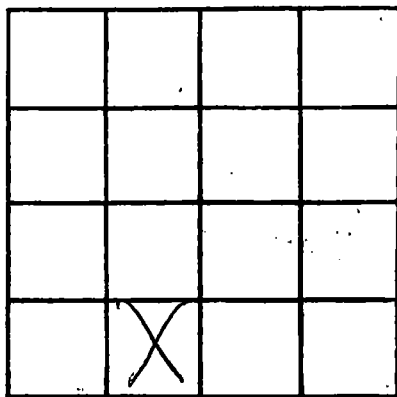

SECTION _____

Please indicate well location X.

ADDITIONAL INFORMATION

If more than one screen, show locations of each on sketch.