

MISSISSIPPI DEPARTMENT OF NATURAL RESOURCES

Bureau of Land and Water Resources

Southport Mall

P.O. Box 10631

Jackson, Mississippi 39209

WATER WELL DRILLERS LOG

H 2306
Harrison
9-3-85

9-3
date well completed

1985 McMill Pump & Well
firm name

Harrison
county well located

LANDOWNER: George Bennett
101 Mill Creek Estates

(mailing address)

WELL LOCATION:

sec. 33 T. 6 N. R. 10 E.
2 miles N of Woolmarket
(distance) (direction) (nearest town)

WELL PURPOSE:

(home, irrigation, municipal, industrial)

WELL COMPLETION DATA:

- (1) diameter (inches) 2"
- (2) total depth (feet) 440'
- (3) static water level (feet) 60 ^{below}/_{above} top of ground.
- (4) casing Sch 40 PVC 430'
(material) (depth)
- If telescope see back.
(size)
- (5) screen 20' 430'
(length) (depth to top)
- 2" Sch 80 PVC - 6.6lb
(size) (material)
- (6) pump 1 8
(HP) (yield gpm)
- Elec
(type power)
- (7) electric log
(yes or no)

(organization running log)

- (8) how well bottom plugged SAND
SHARK

DRILLERS REMARKS:


description of formations encountered	from	to
Mud	0	20
Mud/Sand	20	100
Mud	100	120
Mud/Sand	120	160
Mud	160	200
Mud/Sand	200	220
Mud	220	370
Sand	370	440

RECEIVED

OCT - 8 1985

If well telescopes please sketch and show depths.

GROUND LEVEL

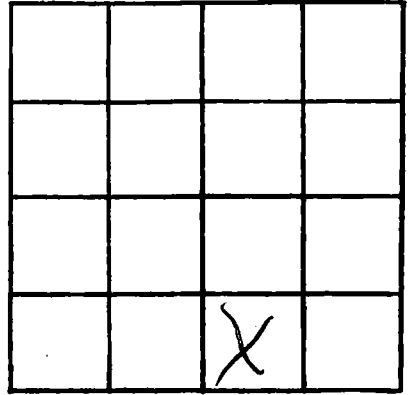

SECTION _____

Please indicate well location X.

ADDITIONAL INFORMATION

If more than one screen, show locations of each on sketch.