

MISSISSIPPI DEPARTMENT OF NATURAL RESOURCES
Bureau of Land and Water Resources
 Southport Mall
 P.O. Box 10631
 Jackson, Mississippi 39209
WATER WELL DRILLERS LOG

Harrison
H
2309

July 25, 1985, Coast water well Harrison
 (date well completed) firm name county well located

LANDOWNER: Herbert Howard
Rt 6, Box 148C
Biloxi, Miss.
 (mailing address) 39532

WELL LOCATION:
 sec. 7 T. 6 S. R. 9 E.
8 miles N of Biloxi
 (distance) (direction) (nearest town)

WELL PURPOSE: Home
 (home, irrigation, municipal, industrial)

WELL COMPLETION DATA:

- (1) diameter (inches) 2"
- (2) total depth (feet) 315'
- (3) static water level (feet) 43 below top of ground
- (4) casing PC, 300'
 (material) (depth)
2" If telescope see back.
 (size)
- (5) screen 10', 300'
 (length) (depth to top)
2" PC
 (size) (material)
- (6) pump _____
 (HP) (yield gpm)

 (type power)
- (7) electric log no
 (yes or no)

 (organization running log)
- (8) how well bottom plugged Backwash valve

description of formations encountered	from to	
Top Soil	0'	1'
Gray Coarse Sand	1'	4'
Red + Gray Clay	4'	15'
Blue Clay	15'	27'
Red Coarse Sand	27'	37'
White Clay	37'	50'
Blue Clay + Gravel	50'	60'
Blue Clay	60'	70'
Gray Fine Sand	70'	80'
Blue Clay	80'	130'
Blue Clay & streaks of sand	130'	150'
Gray Fine Sand	150'	162'
Blue Clay	162'	278'
Gray Coarse Sand	278'	312'
Blue Clay	312'	315'


RECEIVED
 NOV - 5 1985

DRILLERS REMARKS: _____

Department of Natural Resources
 Bureau of Land & Water Resources

If well telescopes please sketch and show depths.

GROUND LEVEL

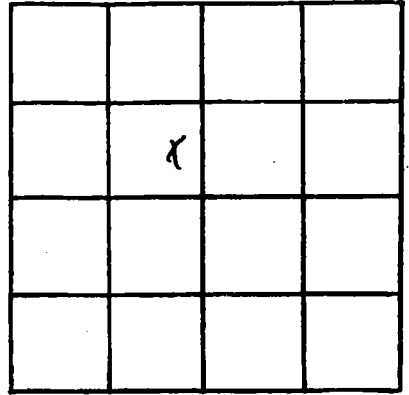

SECTION 7

Please indicate well location X.

ADDITIONAL INFORMATION

Multiple horizontal lines for additional information.

If more than one screen, show locations of each on sketch.