

MISSISSIPPI DEPARTMENT OF NATURAL RESOURCES
Bureau of Land and Water Resources
 Southport Mall
 P.O. Box 10631
 Jackson, Mississippi 39209
WATER WELL DRILLERS LOG

832-3701
 HARRISON
 H
 2310

9-11-85 date well completed
 Coast Water Well Serv. Harrison firm name
 county well located

LANDOWNER: Kenneth Hudson
 Rt. 5 Box 587
 Gulfport, Miss.
 (mailing address) 39503

WELL LOCATION:
 sec. 31 T. 6 N. R. 10 W.
 1 miles West of WOODMARKET
 (distance) (direction) (nearest town)

WELL PURPOSE: Home
 (home, irrigation, municipal, industrial)

WELL COMPLETION DATA:

(1) diameter (inches) 2"
 (2) total depth (feet) 297'
 (3) static water level (feet) 38' below top of ground
 (4) casing PVC, 287' (material) (depth)
 (size) If telescope see back.
 (5) screen 10', 287' (length) (depth to top)
 2" PVC (size) (material)
 (6) pump (HP) (yield gpm)
 (type power)
 (7) electric log No (yes or no)
 (organization running log)
 (8) how well bottom plugged Pack wash valve

description of formations encountered	from	to
Top soil	0	2'
Red Clay	2'	9'
Blue Clay	9'	17'
Blue Clay & clam shell	17'	45'
Gray coarse sand	45'	60'
Gray coarse sand to wood	60'	64'
Blue Clay	64'	220'
Blue Clay & shell	220'	237'
Blue Clay	237'	268'
Gray coarse sand	268'	292'
Blue Clay	292'	297'


RECEIVED
 NOV 26 1985

DRILLERS REMARKS:
 5" 2" Tail Pipe
 Shell Catcher

Department of Natural Resources
 Bureau of Land & Water Resources

If well telescopes please sketch and show depths.

GROUND LEVEL

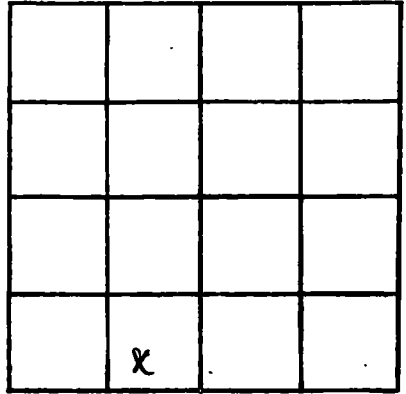

SECTION 31

Please indicate well location X.

ADDITIONAL INFORMATION

If more than one screen, show locations of each on sketch.