

HARRISON
H
2312

MISSISSIPPI DEPARTMENT OF NATURAL RESOURCES
Bureau of Land and Water Resources
Southport Mall
P.O. Box 10631
Jackson, Mississippi 39209
WATER WELL DRILLERS LOG

10-19-85 date well completed 19
McNeil Pump & Well firm name Harrison county well located

LANDOWNER: Bobby McKenzie
Rt. 2 Box 536
Bellevue Mo. 39532
(mailing address)

description of formations encountered	depth	
	from	to
Mud	0	10
Sand	10	70
Mud	70	290
Sand / Mud	290	310
Sand	310	340

WELL LOCATION:
sec. 36 T. 6 N. R. 10 E.
5 miles NE of Bellevue
(distance) (direction) (nearest town)

WELL PURPOSE:
(home, irrigation, municipal, industrial)

- WELL COMPLETION DATA:
- (1) diameter (inches) 2"
 - (2) total depth (feet) 340'
 - (3) static water level (feet) 60' below above top of ground.
 - (4) casing Sch. 40 PVC, 330'
(material) (depth)
 - _____ if telescope see back.
(size)
 - (5) screen 10', 330'
(length) (depth to top)
 - 2", Sch. 80 PVC - 6 slot
(size) (material)
 - (6) pump 1 8
(HP) (yield gpm)
 - ELEC.
(type power)
 - (7) electric log _____
(yes or no)
 - _____ (organization running log)
 - (8) how well bottom plugged SAND
SHARK


RECEIVED
NOV 20 1985

DRILLERS REMARKS:

Department of Natural Resources
Bureau of Land & Water Resources

If well telescopes please sketch and show depths.

GROUND LEVEL

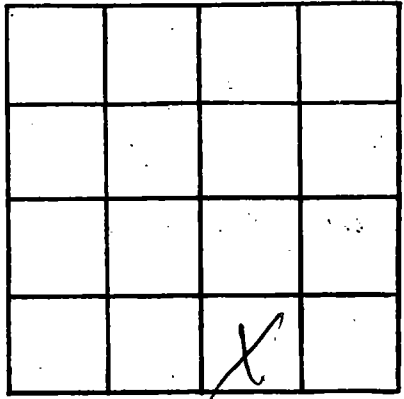

SECTION _____

Please indicate well location X.

ADDITIONAL INFORMATION

If more than one screen, show locations of each on sketch.