

MISSISSIPPI DEPARTMENT OF NATURAL RESOURCES

Bureau of Land and Water Resources

Southport Mall

P.O. Box 10631

Jackson, Mississippi 39209

WATER WELL DRILLERS LOG

COASTAL DRILLING & SERVICE CO.

Harrison  
H  
2320

0/20/85

date well completed

19

RT. 11, BOX 81

From Form 81

county well located

Harrison

BILOXI, MS 39532

LANDOWNER: Ed Sargent

description of formations encountered

from

to

Riversland Estates

top soil

1 10

Biloxi, miss  
(mailing address)

2' clear sand

10 20

WELL LOCATION:

sec. 33 T. 6 N. R. 10 E  
S W

red clay

20 180

hard blue clay

180 290

fine water sand

290 310

good water sand

310 320

Woodmantz of Wald  
(distance) (direction) (nearest town)

WELL PURPOSE: Home  
(home, irrigation, municipal, industrial)

WELL COMPLETION DATA:

- (1) diameter (inches) 4" x 2"
- (2) total depth (feet) 310
- (3) static water level (feet) 15 below above top of ground.

(4) casing PVC, 305  
(material) (depth)  
4" x 2"  
(size) if telescope see back.

(5) screen 15', 305  
(length) (depth to top)

2", PVC  
(size) (material)

(6) pump 1, 8  
(HP) (yield gpm)

ETC  
(type power)

(7) electric log NO  
(yes or no)

(organization running log)

(8) how well bottom plugged 2" back wash valve

DRILLERS REMARKS:

RECEIVED

DEC 20 1985

Department of Natural Resources  
Bureau of Land & Water Resources

If well telescopes please sketch and show depths.


GROUND LEVEL

160" 4" pvc

150" 2" pvc

15" pvc screens

2" back wash valve

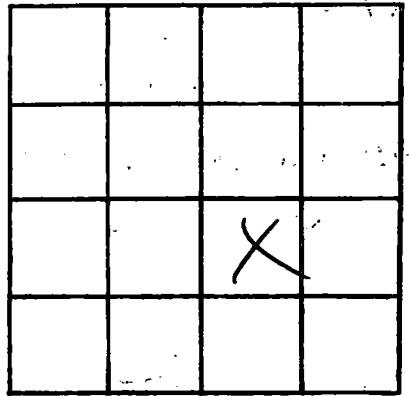

SECTION \_\_\_\_\_

Please indicate well location X.

ADDITIONAL INFORMATION

If more than one screen, show locations of each on sketch.