

MISSISSIPPI DEPARTMENT OF NATURAL RESOURCES

Bureau of Land and Water Resources

Southport Mall

P.O. Box 10631

Jackson, Mississippi 39209

WATER WELL DRILLERS LOG

COASTAL DRILLING & SERVICE *CO Harrison*  
 Rt. 1 *Box 81* county well located

HARRISON
H
2324

5/16/85  
 date well completed 19

LANDOWNER: *Joe Babin*  
*High 15*  
*Biloxi, MS 39532*  
 (mailing address)

description of formations encountered	from	to
top soil	1	10
sea sand	10	20
red clay	20	175
fine water sand	175	185
coarse water sand	185	195

WELL LOCATION:  
 sec. *32* T. *6* N. R. *9* E  
 S W  
*High 15* miles (distance) of (direction) of (nearest town)

WELL PURPOSE: *home*  
 (home, irrigation, municipal, industrial)

- WELL COMPLETION DATA:
- (1) diameter (inches) *4" x 2"*
  - (2) total depth (feet) *195*
  - (3) static water level (feet) *15* below above top of ground.
  - (4) casing *pvc*, *180*,  
 (material) (depth)  
*4" x 2"*  
 (size) if telescope see back.
  - (5) screen *15*, *180*  
 (length) (depth to top)  
*2"*, *pvc*  
 (size) (material)
  - (6) pump *1*, *10*  
 (HP) (yield gpm)  
*etc*  
 (type power)
  - (7) electric log *no*  
 (yes or no)

(organization running log)  
 (8) how well bottom plugged *2" back*  
*wash case*

DRILLERS REMARKS:


**RECEIVED**  
 DEC 20 1985

Department of Natural Resources  
 Bureau of Land & Water Resources

If well telescopes please sketch and show depths.

GROUND LEVEL

160' 4" PVC

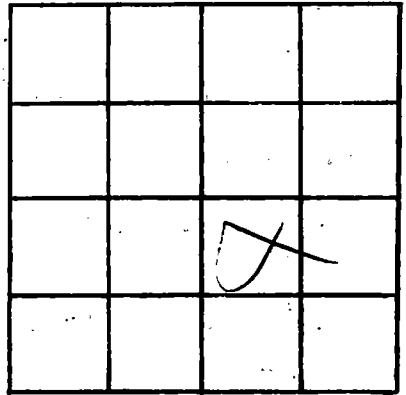

SECTION \_\_\_\_\_

Please indicate well location X.

ADDITIONAL INFORMATION

35' 2" PVC

15" PVC screen

2" back wash valve

If more than one screen, show locations of each on sketch.