

MISSISSIPPI DEPARTMENT OF NATURAL RESOURCES

Bureau of Land and Water Resources

Southport Mall

P.O. Box 10631

Jackson, Mississippi 39209

WATER WELL DRILLERS LOG

HARRISON
H
2326

11-9-85  
date well completed

*James*  
firm name

HARRISON  
county well located

LANDOWNER: PAUL SMITH  
MILL CREEK ESTATES  
LOT 17 WOOL MARKET

description of formations encountered

from

to

Bloomington

(mailing address)

WELL LOCATION:

sec. 28 T. 6 N. R. 10 E.  
2 miles N of Wool Market  
(distance) (direction) (nearest town)

TOP SOIL	0	30
Red Sand	30	50
White Clay	50	100
Blue Clay	100	400
Med Sand	400	440

WELL PURPOSE:

(home, irrigation, municipal, industrial)

WELL COMPLETION DATA:

- (1) diameter (Inches) 3"
- (2) total depth (feet) 440'
- (3) static water level (feet) 60' below top of ground.
- (4) casing PVC, 440' (material) (depth)

(size) if telescope see back.

- (5) screen 2' x 10', 440' (length) (depth to top)
- 2" PVC (size) (material)


- (6) pump 1/2 (HP) 8 (yield gpm)
- F (type power)

- (7) electric log (yes or no)

(organization running log)

- (8) how well bottom plugged *PVC*

DRILLERS REMARKS:

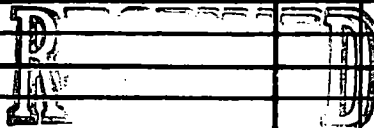


JAN 11 1985

Department of Natural Resources  
Bureau of Land and Water Resources

If well telescopes please sketch and show depths.

GROUND LEVEL

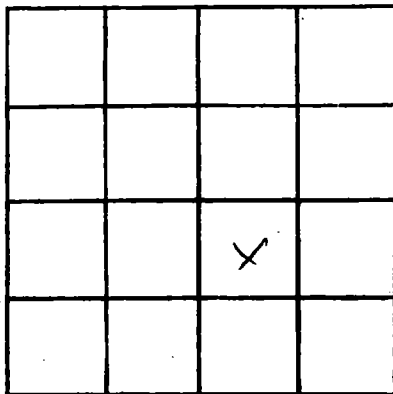

SECTION 28

Please indicate well location X.

ADDITIONAL INFORMATION

If more than one screen,  
show locations of each on sketch.