

MISSISSIPPI DEPARTMENT OF NATURAL RESOURCES

Bureau of Land and Water Resources

Southport Mall

P.O. Box 10631

Jackson, Mississippi 39209

WATER WELL DRILLERS LOG

HARMON  
H  
2327

12-10-85 19  
 date well completed

R. Imoore  
 firm name

HARRIS CO  
 county well located

LANDOWNER: C. N. Williams  
Hwy 67  
CARR BLDG RD

B/Lowms  
 (mailing address)


WELL LOCATION:  
 sec. 8 T. 6S R. 10E  
6 miles N of Wool Lake  
 (distance) (direction) (nearest town)

WELL PURPOSE:  
 (home, irrigation, municipal, industrial)

WELL COMPLETION DATA:

- (1) diameter (inches) 4 x 2
- (2) total depth (feet) 505
- (3) static water level (feet) 160' <sup>below</sup> above top of ground.
- (4) casing PVC 505'  
 (material) (depth)  
 (size) if telescope see back.
- (5) screen 2' x 20' 505'  
 (length) (depth to top)  
 (size) (material)
- (6) pump 2 22  
 (HP) (yield gpm)  
E  
 (type power)
- (7) electric log                       
 (yes or no)  
 (organization running log)
- (8) how well bottom plugged PVC

description of formations encountered	from	to
TOP SOIL	0	20
red & white clay	20	80
Blue clay	80	260
med sand	260	280
Blue clay	280	460
med sand	460	480
clay sand	480	505
260' 4" PVC		
235' 2" PVC		

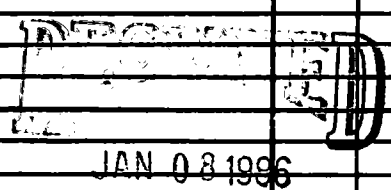


Department of Natural Resources  
 Bureau of Land & Water Resources

DRILLERS REMARKS:

If well telescopes please sketch and show depths.

GROUND LEVEL

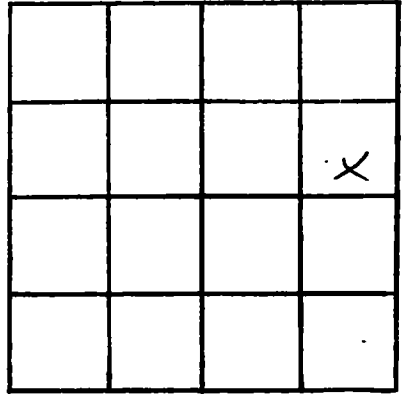

SECTION X

Please indicate well location X.

ADDITIONAL INFORMATION

If more than one screen, show locations of each on sketch.