

MISSISSIPPI DEPARTMENT OF NATURAL RESOURCES

Bureau of Land and Water Resources

Southport Mall

P.O. Box 10631

Jackson, Mississippi 39209

WATER WELL DRILLERS LOG  
COASTAL DRILLING & SERVICE CO.

Harrison  
H  
2329

11/23/85 19  
date well completed

RT. 11 BOX 81  
Name

Harrison  
county well located

BILOXI, MS 39532

LANDOWNER: Bill Pierce

RT. 3 Box 50

BILOXI, MS  
(mailing address)

WELL LOCATION:

sec 27 T 6 N R 10 E  
S W

BILOXI, (distance) (direction) of (nearest town)

WELL PURPOSE: home  
(home, irrigation, municipal, industrial)

WELL COMPLETION DATA:

- (1) diameter (inches) 2"
- (2) total depth (feet) 300
- (3) static water level (feet) 10 below above top of ground.

(4) casing PVC, 290  
(material) (depth)  
(size) if telescope see back.

(5) screen 10", 290  
(length) (depth to top)  
2", PVC  
(size) (material)

(6) pump 1, 9  
(HP) (yield gpm)  
elec.  
(type power)

(7) electric log NO  
(yes or no)

(organization running log)

(8) how well bottom plugged 2" back wash water

description of formations encountered

from to

top soil	1	5
sugar sand	5	20
red clay	20	180
hard blue clay	150	280
fine water sand	280	290
deep water sand	290	300

RECEIVED


FEB 14 1986

Department of Natural Resources  
Bureau of Land & Water Resources

DRILLERS REMARKS:

If well telescopes please sketch and show depths.

GROUND LEVEL

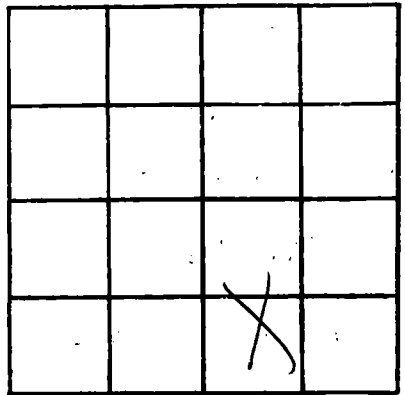

SECTION \_\_\_\_\_

Please indicate well location X.

ADDITIONAL INFORMATION

If more than one screen, show locations of each on sketch.