

MISSISSIPPI DEPARTMENT OF NATURAL RESOURCES

Bureau of Land and Water Resources

Southport Mall

P.O. Box 10631

Jackson, Mississippi 39209

WATER WELL DRILLERS LOG  
COASTAL DRILLING & SERVICE CO.

Harrison  
H  
2330

11/23/85  
date well completed

RT. 11 BOX 81  
High Road

Harrison  
county well located

BILOXI, MS 39532

LANDOWNER: Alex Lindsey  
Woolmarket Rd.  
Biloxi, MS  
(mailing address)

description of formations encountered	from	to
top soil	1	5
red clay	5	45
hard blue clay	45	210
seagard sand	210	330
soft blue clay	330	385
fine water sand	385	400
lagoon water sand	400	410

WELL LOCATION:  
sec. 35 T. 6 N. R. 9 E.  
S. W.


Woolmarket  
(distance) miles (direction) of (nearest town)

WELL PURPOSE: Home  
(home, irrigation, municipal, industrial)

- WELL COMPLETION DATA:
- (1) diameter (Inches) 4" x 2"
  - (2) total depth (feet) 410
  - (3) static water level (feet) 15 below above top of ground.
  - (4) casing pvc, 395  
(material) (depth)  
4" x 2" if telescope see back.  
(size)
  - (5) screen 10", 395  
(length) (depth to top)  
2", pvc  
(size) (material)
  - (6) pump 1, 11  
(HP) (yield gpm)  
elec.  
(type power)
  - (7) electric log NO  
(yes or no)

(organization running log)  
(8) how well bottom plugged 2" pack  
wash water

DRILLERS REMARKS:

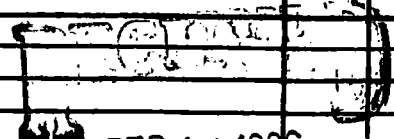

FEB 14 1986

Department of Natural Resources  
Bureau of Land & Water Resources

