

MISSISSIPPI DEPARTMENT OF NATURAL RESOURCES

Bureau of Land and Water Resources

Southport Mall

P.O. Box 10631

Jackson, Mississippi 39209

WATER WELL DRILLERS LOG

COASTAL DRILLING & SERVICE CO.

Hanson
H
2331

8/26/85 19

NT. 41 BOX 81

county well located

LANDOWNER: BDO Fds of G
Forest Drive
Gulfport, MS
(mailing address)

Description of formations encountered	MS 39532	
	from	to
topsoil	1	3
sugar sand	3	15
blue clay	15	170
red clay	170	255
fine water sand	255	265
hard water sand	265	280

WELL LOCATION:
sec. 22 T. 6 N. R. 10 E. S. W
Gulfport of _____
(distance) (direction) (nearest town)

WELL PURPOSE: home
(home, irrigation, municipal, industrial)

WELL COMPLETION DATA:

- (1) diameter (Inches) 4" 1/2"
- (2) total depth (feet) 280
- (3) static water level (feet) 15 below above top of ground.
- (4) casing PVC, 265,
(material) (depth)
4" 1/2" If telescope see back.
(size)
- (5) screen 15, 265
(length) (depth to top)
2", PVC
(size) (material)
- (6) pump 1, 11
(HP) (yield gpm)
elec.
(type power)
- (7) electric log NO
(yes or no)
(organization running log)
- (8) how well bottom plugged 2" back
wash (blue)

DRILLERS REMARKS:

RECEIVED

FEB 14 1986

Department of Natural Resources
Bureau of Land & Water Resources

If well telescopes please sketch and show depths.

GROUND LEVEL


160' 4" PVC
Casing

120' 2" PVC
Casing

15' 2" PVC
Screen

2" BACK
WASH
VALVE

If more than one screen,
show locations of each on sketch.

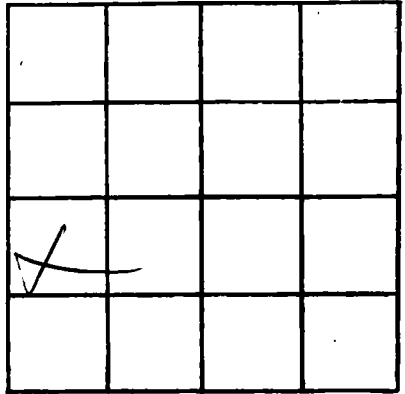

SECTION _____

Please indicate well location X.

ADDITIONAL INFORMATION

Multiple horizontal lines for additional information.