

MISSISSIPPI DEPARTMENT OF NATURAL RESOURCES

Bureau of Land and Water Resources

Southport Mall

P.O. Box 10631

Jackson, Mississippi 39209

WATER WELL DRILLERS LOG

COASTAL DRILLING & SERVICE CO.

Harrison

2332

12/13/85 19 Jan Miss Harrison
date well completed Pt. of well located county well located

LANDOWNER: John Reed

Woolmarket Rd.

Biloxi, MS
(mailing address)

WELL LOCATION:

sec. 35 T. 6 N. R. 9 E
S W

Woolmarket Rd.
(distance) (direction) (nearest town)

WELL PURPOSE: home
(home, irrigation, municipal, industrial)

WELL COMPLETION DATA:

- (1) diameter (inches) 2"
- (2) total depth (feet) 470
- (3) static water level (feet) 10 below above top of ground.
- (4) casing PVC, 460,
(material) (depth)
(size) if telescope see back.
- (5) screen 10, 460
(length) (depth to top)
2"
(size) PVC
(material)
- (6) pump 1 10
(HP) (yield gpm)
ELC
(type power)
- (7) electric log NO
(yes or no)

(organization running log)

(8) how well bottom plugged 2" back
wash valve

39532

description of formations encountered	from	to
	top soil	1
sugar sand	5	20
blue clay	20	180
red clay	180	370
soft blue clay	370	450
fine water sand	450	460
lumpy water sand	460	470

DRILLERS REMARKS:


RECEIVED

FEB 14 1986

Department of Natural Resources
Bureau of Land & Water Resources

If well telescopes please sketch and show depths.

GROUND LEVEL

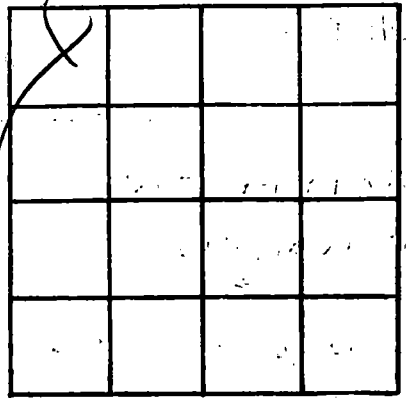

SECTION _____

Please indicate well location X.

ADDITIONAL INFORMATION

If more than one screen, show locations of each on sketch.