

MISSISSIPPI DEPARTMENT OF NATURAL RESOURCES

Bureau of Land and Water Resources

Southport Mall

P.O. Box 10631

Jackson, Mississippi 39209

WATER WELL DRILLERS LOG

CRISTAL DRILLING & SERVICE CO.

Harrison
A
2834

11/23/85 1985 RT. 11, BOX 81 Harrison
date well completed farm name county well located

BILOXI, MS 39532
LANDOWNER: Henry Hladis
Rt 2, Box 85
Biloxi, MS
(mailing address)

description of formations encountered	from	to
top soil	1	10
red clay	10	120
Soft + bleed clay	120	250
hard blue clay	250	395
sugar sand	395	420
red clay	420	600
hard blue clay	600	710
Soft blue clay	710	820
fine water sand	820	830
Good water sand	830	840

WELL LOCATION:
sec. 32 T. 6-N R. 10-E
S W

Biloxi miles of RT. 11 (direction) of (nearest town)

WELL PURPOSE: none
(home, irrigation, municipal, industrial)

- WELL COMPLETION DATA:
- (1) diameter (inches) 4" x 2"
 - (2) total depth (feet) 840
 - (3) static water level (feet) 15 below above top of ground.
 - (4) casing PVC, 840,
(material) (depth)
4" x 2" if telescope see back.
(size)
 - (5) screen 10', 840
(length) (depth to top)
2", PVC
(size) (material)
 - (6) pump 1, 9
(HP) (yield gpm)
etc.
(type power)
 - (7) electric log NO
(yes or no)

(organization running log)
(8) how well bottom plugged 2" back washable

DRILLERS REMARKS:

RECEIVED
FEB 24 1986

Department of Natural Resources
Bureau of Land and Water Resources

If well telescopes please sketch and show depths.


GROUND LEVEL

180' 4" pvc casing

660' 2" pvc casing

10' 2" pvc screen

2" backwash valve

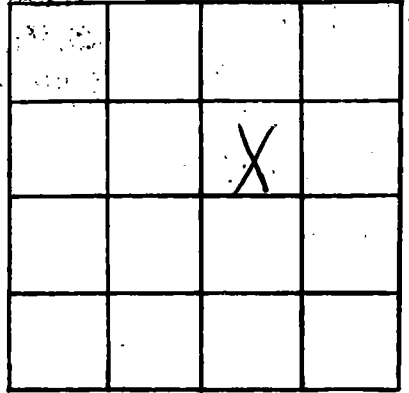

SECTION _____

Please indicate well location X.

ADDITIONAL INFORMATION

If more than one screen, show locations of each on sketch.