

MISSISSIPPI DEPARTMENT OF NATURAL RESOURCES

Bureau of Land and Water Resources

Southport Mall

P.O. Box 10631

Jackson, Mississippi 39209

WATER WELL DRILLERS LOG

COASTAL DRILLING & SERVICE CO.

Harrison
H
2336

12/5/85 19 RT. 11, BOX 84, name Harrison county well located

LANDOWNER: Doug Gill
Timey Road
Beloxi, MS
 (mailing address)

description of formations encountered	from	to
top soil	1	10
red clay	10	220
soft blue clay	220	400
hard blue clay	400	580
fine water sand	580	615
bad water sand	615	625

WELL LOCATION:
 sec. 6 T. 6 N. R. 10 E. S. 5 W.
Beloxi miles (distance) of (direction) of (nearest town)

WELL PURPOSE: home
 (home, irrigation, municipal, industrial)

- WELL COMPLETION DATA:
- (1) diameter (inches) 2"
 - (2) total depth (feet) 625
 - (3) static water level (feet) 15 below above top of ground.
 - (4) casing PVC 610 (material) (depth) (size) If telescope see back.
 - (5) screen 10 610 (length) (depth to top) 2" PVC (size) (material)
 - (6) pump 1 8 (HP) (yield gpm) etc. (type power)
 - (7) electric log NO (yes or no) (organization running log)
 - (8) how well bottom plugged 2" back wash valve


RECEIVED
 FEB 24 1986

Department of Natural Resources
 Bureau of Land & Water Resources

DRILLERS REMARKS:

If well telescopes please sketch and show depths.

GROUND LEVEL

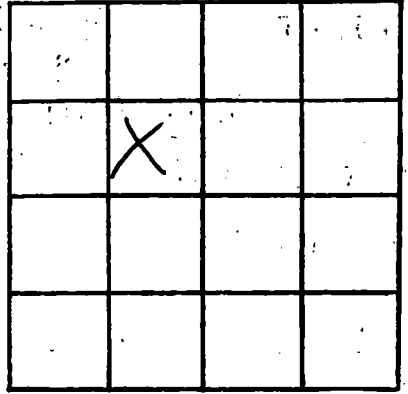

SECTION _____

Please indicate well location X.

ADDITIONAL INFORMATION

If more than one screen,
show locations of each on sketch.