

MISSISSIPPI DEPARTMENT OF NATURAL RESOURCES

Bureau of Land and Water Resources

Southport Mall

P.O. Box 10631

Jackson, Mississippi 39209

WATER WELL DRILLERS LOG

COASTAL DRILLING & SERVICE CO.,

HARRISON
H
2339

12/16/85
date well completed

RT. 11, BOX 81
firm name

Harrison
county well located

BILOXI, MS 39532

LANDOWNER: Danny WILKINSON

description of formations encountered

from

to

POPPS Ferry Rd.

top soil

1

15

yellow sand

15

25

red clay

25

190

blue clay

190

350

red clay

350

490

fine water sand

490

500

good water sand

500

510

WELL LOCATION:

sec 7 T 6 N R 9 E
S W

Biloxi miles of (distance) (direction) (nearest town)

WELL PURPOSE:

(home, irrigation, municipal, industrial)

WELL COMPLETION DATA:

- (1) diameter (Inches) 2"
- (2) total depth (feet) 510
- (3) static water level (feet) 10 below above top of ground.

- (4) casing PVC, 510 (material) (depth)
(size) if telescope see back.

- (5) screen 10', 510 (length) (depth to top)
2", PVC (size) (material)

- (6) pump 1, 9 (HP) (yield gpm)
FLC (type power)

- (7) electric log NO (yes or no)
(organization running log)

- (8) how well bottom plugged _____

DRILLERS REMARKS:


RECEIVED
DEC 21 1985

Department of Natural Resources
Bureau of Land & Water Resources

If well telescopes please sketch and show depths.

GROUND LEVEL

1
2
3
4
5
6
7
8
9
10

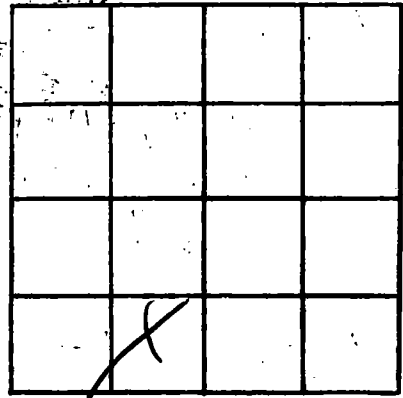

SECTION _____

Please indicate well location X.

ADDITIONAL INFORMATION

If more than one screen, show locations of each on sketch.