

MISSISSIPPI DEPARTMENT OF NATURAL RESOURCES

Bureau of Land and Water Resources

Southport Mall

P.O. Box 10631

Jackson, Mississippi 39209

WATER WELL DRILLERS LOG
COASTAL DRILLING & SERVICE CO.

Harrison
H
2343

12/21/85

date well completed

RT. 11, BOX 21

firm name

Harrison

county well located

BILOXI, MS 39532

LANDOWNER: Margie Sewell

description of formations encountered

from

to

off Jim Burd Rd.

top soil

1

10

red clay

10

100

soft blue clay

100

185

hard blue clay

185

250

red clay

250

315

fine water sand

315

325

good water sand

325

335

(mailing address)

WELL LOCATION:

sec. 27 T. 6 N. R. 10 E. S. W.

Jim Burd Rd. (distance) miles (direction) of (nearest town)

WELL PURPOSE: home (home, irrigation, municipal, industrial)

WELL COMPLETION DATA:

- (1) diameter (inches) 2"
- (2) total depth (feet) 335
- (3) static water level (feet) 10 below above top of ground.
- (4) casing PVC, 325 (material), (depth), (size) if telescope see back.
- (5) screen 10' 325 (length), (depth to top), 2" PVC (size), (material)
- (6) pump 1 8 (HP), (yield gpm), ELC (type power)
- (7) electric log No (yes or no)

(organization running log)

(8) how well bottom plugged 2" back wash valve.

DRILLERS REMARKS:

RECEIVED


FEB 24 1986

Department of Natural Resources
Bureau of Land & Water Resources

If well telescopes please sketch and show depths.

GROUND LEVEL

Handwritten notes and data, including a list of numbers (e.g., 200, 201, 202, 299, 300) and other illegible text.

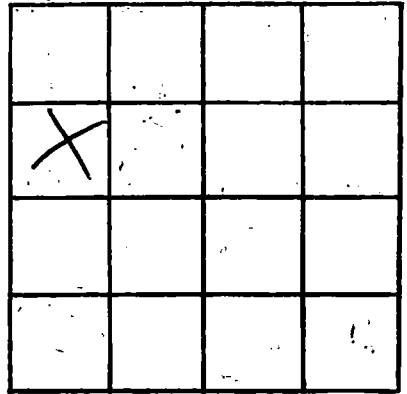

SECTION _____

Please indicate well location X.

ADDITIONAL INFORMATION

Lined area for additional information.

If more than one screen, show locations of each on sketch.