

MISSISSIPPI DEPARTMENT OF NATURAL RESOURCES

Bureau of Land and Water Resources

Southport Mall

P.O. Box 10631

Jackson, Mississippi 39209

WATER WELL DRILLERS LOG
COASTAL DRILLING & SERVICE CO.

Harrison
H
2344

12/25/85

date well completed

RT. 11, BOX 23

firm name

BILOXI, MS 39532

county well located

LANDOWNER: Fred Fayard

description of formations encountered

from

to

RT 11 BOX 23

top soil

1 15

Biloxi, ms

silica sand

15 25

(mailing address)

red clay

25 730

WELL LOCATION:

hard blue clay

130 490

sec. 6 T. 10 N. R. 10 E. S. 5 W. W

fine water sand

490 530

wood market

Dept + blue clay

530 590

(distance) miles (direction) of (nearest town)

red clay

590 620

WELL PURPOSE: home
(home, irrigation, municipal, industrial)

fine water sand

620 630

good water sand

630 640

WELL COMPLETION DATA:

(1) diameter (inches) 4" x 2"

(2) total depth (feet) 640

(3) static water level (feet) 15 below above top of ground.

(4) casing pvc to 25
(material) (depth)

4 1/2" x 2"
(size) if telescope see back.

(5) screen 10' 625
(length) (depth to top)

2" pvc
(size) (material)

(6) pump 1 11
(HP) (yield gpm)

etc.
(type power)

(7) electric log No
(yes or no)

(organization running log)

(8) how well bottom plugged 2" back
wash valves

DRILLERS REMARKS:

RECEIVED

FEB 24 1986

Department of Natural Resources
Bureau of Land & Water Resources

If well telescopes please sketch and show depths.


GROUND LEVEL

320' 4" pvc casing

320' 4" pvc casing

10' 2" pvc screen

2" back wash ~~valve~~

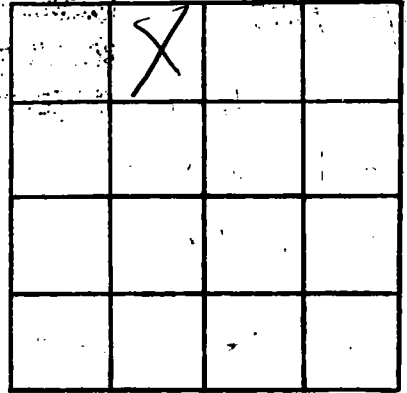

SECTION _____

Please indicate well location X.

ADDITIONAL INFORMATION

If more than one screen, show locations of each on sketch.