

MISSISSIPPI DEPARTMENT OF NATURAL RESOURCES
Bureau of Land and Water Resources
 Southport Mall
 P.O. Box 10631
 Jackson, Mississippi 39209
WATER WELL DRILLERS LOG

Harrison
H
2395

12-31-80 19 McMillan Drilling Harrison
 date well completed firm name county well located

LANDOWNER: James Needy
P.O. Box 777-A
Biloxi, MS.
 (mailing address)

description of formations encountered	from	to
clay	0	230
sand	230	240
clay	240	270
mucl sand	370	420
sand	430	440

WELL LOCATION:
 sec. 34 T 6 N R 10 E
3 miles E of Waterford
 (distance) (direction) (nearest town)

WELL PURPOSE:
 (home, irrigation, municipal, industrial)

WELL COMPLETION DATA:

(1) diameter (inches) 2"

(2) total depth (feet) 440'

(3) static water level (feet) 65' below/above top of ground

(4) casing 40' 450'
 (material) (depth)

_____ If telescope see back.
 (size)

(5) screen 10' 450'
 (length) (depth to top)

5' metal
 (size) (material)

(6) pump 1 8-10
 (HP) (yield gpm)

elec.
 (type power)

_____ electric log (yes or no)

_____ organization running log

(8) how well bottom plugged Seal


DRILLERS REMARKS:

RECEIVED
 MAY 6 1981

Department of Natural Resources
 Bureau of Land & Water Resources

If well telescopes please sketch and show depths.

GROUND LEVEL

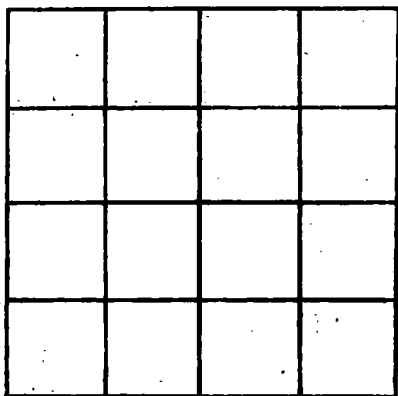

SECTION _____

Please indicate well location X.

ADDITIONAL INFORMATION

If more than one screen, show locations of each on sketch.