

MISSISSIPPI DEPARTMENT OF NATURAL RESOURCES

Bureau of Land and Water Resources

Southport Mall

P.O. Box 10631

Jackson, Mississippi 39209

WATER WELL DRILLERS LOG

Harrison
H
2346

1-11-86 date well completed 19 McGill Pump & Well firm name Harrison county well located

LANDOWNER: Licky Busarge
1600 Nishoba St.

Biloxi, Ms.
(mailing address)

WELL LOCATION:

sec. 4 T. 6 N. R. 9 E. W
2 miles N of Dilworth
(distance) (direction) (nearest town)


WELL PURPOSE:
(Home, Irrigation, municipal, Industrial)

WELL COMPLETION DATA:

- (1) diameter (inches) 2"
- (2) total depth (feet) 330'
- (3) static water level (feet) 160' below top of ground.
- (4) casing 3.50'
(material) (depth)
- (size) if telescope see back.
- (5) screen 10' 330'
(length) (depth to top)
- 2"
(size) (material)
- (6) pump 1 8-10
(HP) (yield gpm)
- electric
(type power)
- electric log (yes or no)
- (organization running log)
- (8) how well bottom plugged Seal

description of formations encountered	from	to
Sand	0	80
Mud	80	120
Sandy	120	190
Thin sand	190	260
Thin sand	260	300
F. sand	300	330


DRILLERS REMARKS:

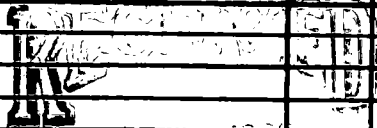

Department of Natural Resources
Bureau of Land & Water Resources

If well telescopes please sketch and show depths.

GROUND LEVEL

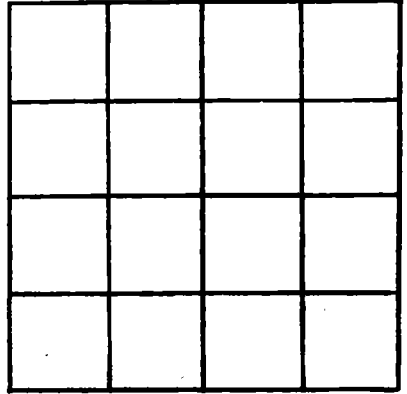

SECTION _____

Please indicate well location X.

ADDITIONAL INFORMATION

If more than one screen, show locations of each on sketch.