

MISSISSIPPI DEPARTMENT OF NATURAL RESOURCES

Bureau of Land and Water Resources

Southport Mall

P.O. Box 10631


Jackson, Mississippi 39209

WATER WELL DRILLERS LOG

HARRISON
H
2347

2/20/86 1986 Coast Water Well Serv. Harrison
date well completed firm name county well located

LANDOWNER	description of formations encountered	from	to
<u>James Brown</u> <u>Rt 2 Box 306 H-1</u> <u>Biloxi ms 39532</u> (mailing address)	<u>Top Soil</u>	<u>0</u>	<u>2</u>
	<u>Brown Clay</u>	<u>2</u>	<u>10</u>
WELL LOCATION: sec. <u>29</u> T. <u>6</u> N. R. <u>9</u> E. <u>5</u> miles <u>N</u> of <u>Biloxi</u> (distance) (direction) (nearest town)	<u>White Coarse Sand</u>	<u>10</u>	<u>25</u>
WELL PURPOSE: (home, irrigation, municipal, industrial)	<u>Blue Clay</u>	<u>25</u>	<u>190</u>
WELL COMPLETION DATA: (1) diameter (inches) <u>2"</u>	<u>med Sand</u>	<u>190</u>	<u>195</u>
(2) total depth (feet) <u>295 ft</u>	<u>Blue Clay</u>	<u>195</u>	<u>265</u>
(3) static water level (feet) <u>75</u> below top of ground.	<u>White Coarse Sand</u>	<u>265</u>	<u>290</u>
(4) casing <u>PVC</u> , <u>280ft</u> (material) (depth)	<u>Blue Clay</u>	<u>290</u>	<u>295</u>
<u>2"</u> If telescope see back. (size)			
(5) screen <u>10ft</u> , <u>280'</u> (length) (depth to top)			
<u>2"</u> , <u>PVC</u> (size) (material)			
(6) pump <u>1 h.p.</u> (HP) (yield gpm)			
<u>Elect.</u> (type power)			
(7) electric log <u>NO</u> (yes or no)			
(organization running log)			
(8) how well bottom plugged <u>Backwash valve</u>			
DRILLERS REMARKS: <u>5' 2" tail pipe (PVC)</u>			

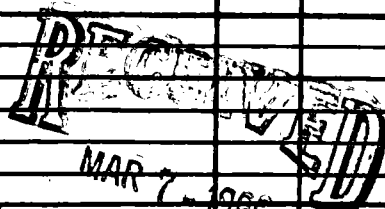

Department of Natural Resources
Bureau of Land & Water Resources

If well telescopes please sketch and show depths.

GROUND LEVEL

			X

SECTION _____

Please indicate well location X.

ADDITIONAL INFORMATION

If more than one screen, show locations of each on sketch.