

MISSISSIPPI DEPARTMENT OF NATURAL RESOURCES
 Bureau of Land and Water Resources
 Southport Mall
 P.O. Box 10631
 Jackson, Mississippi 39209
WATER WELL DRILLERS LOG

HARRISON
H
2348

3-24-86 19 McNiel Pump & Wells Harrison
 date well completed firm name county well located

LANDOWNER: Shelby Auer
216 Woodmarket Rd
Biloxi, Mo.
 (mailing address)

description of formations encountered	from	to
<u>mud</u>	<u>0</u>	<u>400</u>
<u>mud & sand</u>	<u>400</u>	<u>420</u>
<u>sand.</u>	<u>420</u>	<u>480</u>

WELL LOCATION:
 sec 35 T 40 N R 10 E
 S W
5 miles W of Biloxi
 (distance) (direction) (nearest town)

WELL PURPOSE: home
 (home, irrigation, municipal, industrial)


- WELL COMPLETION DATA:
- (1) diameter (inches) 2"
 - (2) total depth (feet) 480'
 - (3) static water level (feet) 40' below above top of ground.
 - (4) casing sch 40 pipe 480'
 (material) (depth)
 - (5) screen 10' 470'
 (length) (depth to top)
2" sch 80 leader
 (size) (material)
 - (6) pump 1 8-10
 (HP) (yield gpm)
 - (7) electric log elec.
 (type power)
 - (8) how well bottom plugged Seal

DRILLERS REMARKS:

RECEIVED
 MAR 28 1986
 Department of Natural Resources
 Bureau of Land & Water Resources

If well telescopes please sketch and show depths.

GROUND LEVEL

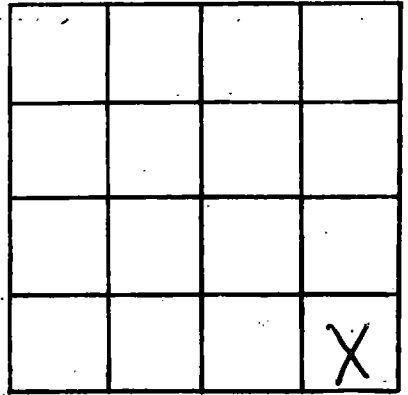

SECTION _____

Please indicate well location X.

ADDITIONAL INFORMATION

If more than one screen, show locations of each on sketch.