

MISSISSIPPI DEPARTMENT OF NATURAL RESOURCES

Bureau of Land and Water Resources

Southport Mall

P.O. Box 10631

Jackson, Mississippi 39209

WATER WELL DRILLERS LOG

Harrison
H
2349

8/31/85
date well completed

Lyman Well Co.
firm name

Harrison
county well located

LANDOWNER: John Fushel
1426 2nd Street
Gulfport, MS 39501
(mailing address)

description of formations encountered	from	to
top soil	0	2
yellow clay	2	6
white sand	6	42
gray mud	42	70
blue clay	70	230
red clay	230	260
blue clay	260	400
sand	400	490

WELL LOCATION:
sec. 30 T. 6 N. R. 10 E
6 miles W of Gulfport
(distance) (direction) (nearest town)

WELL PURPOSE:
(home, irrigation, municipal, industrial)

- WELL COMPLETION DATA:
- (1) diameter (inches) 2"
 - (2) total depth (feet) 413'
 - (3) static water level (feet) 58' ^{below} above top of ground.
 - (4) casing PVC 463'
(material) (depth)
2"
(size) if telescope see back.
 - (5) screen 10' 463'
(length) (depth to top)
2" PVC
(size) (material)
 - (6) pump 1 12
(HP) (yield gpm)
electric
(type power)
 - (7) electric log NO
(yes or no)
NO
(organization running log)
 - (8) how well bottom plugged sand
shark


RECEIVED
APR 9 1986

Department of Natural Resources
Bureau of Land & Water Resources

DRILLERS REMARKS:

If well telescopes please sketch and show depths.

GROUND LEVEL

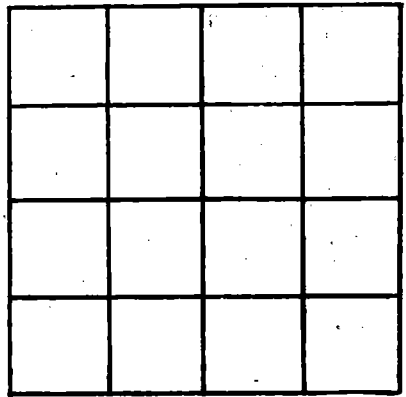

SECTION _____

Please indicate well location X.

ADDITIONAL INFORMATION

If more than one screen,
show locations of each on sketch.