

MISSISSIPPI DEPARTMENT OF NATURAL RESOURCES

Bureau of Land and Water Resources

Southport Mall

P.O. Box 10631

Jackson, Mississippi 39209

WATER WELL DRILLERS LOG

HARRISON
H
2350

11/14/85 19 Lyman Well Co. Harrison
 date well completed firm name county well located

LANDOWNER: Edith Russell
 Rt. 5, Box 581
 Gulfport 39503
 (mailing address)

WELL LOCATION:
 sec. 37 T 6 N R 10 E
 8 miles (distance) N (direction) of Gulfport (nearest town)

WELL PURPOSE: Home
 (home, irrigation, municipal, industrial)

WELL COMPLETION DATA:
 (1) diameter (inches) 4x2
 (2) total depth (feet) 274'
 (3) static water level (feet) 25' below top of ground.
 (4) casing PVC 264' (material) (depth)
 4x2 (size) if telescope see back.
 (5) screen 10' 264' (length) (depth to top)
 2" PVC (size) (material)
 (6) pump 1 25 (HP) (yield gpm)
 electric (type power)
 (7) electric log NO (yes or no)
 NO (organization running log)

(8) how well bottom plugged sand
 shank



DRILLERS REMARKS:

description of formations encountered	from	to
top soil	0	3
gravelly clay	3	7
light sand gravel	7	78
blue clay	78	240
sand	240	270

RECEIVED
 APR - 9 1986
 Department of Natural Resources

If well telescopes please sketch and show depths.

GROUND LEVEL

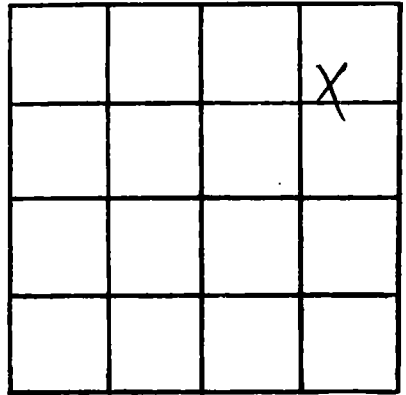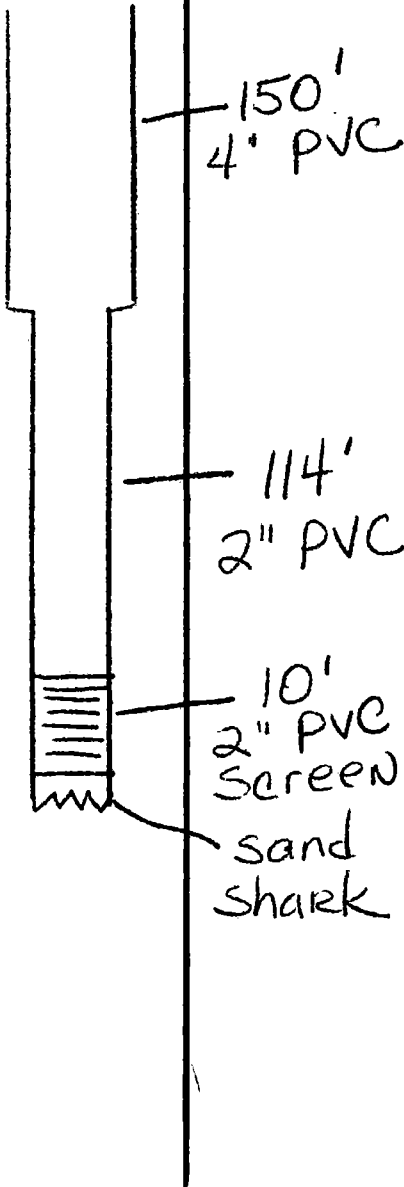

SECTION 31

Please indicate well location X.

ADDITIONAL INFORMATION

If more than one screen,
show locations of each on sketch.