

MISSISSIPPI DEPARTMENT OF NATURAL RESOURCES

Bureau of Land and Water Resources

Southport Mall

P.O. Box 10631

Jackson, Mississippi 39209

WATER WELL DRILLERS LOG

HARRISON
H
2351

Harrison
~~BRADEN~~
county well located

NOV 28 1985 Braden Pump & Well
date well completed firm name

LANDOWNER: E.S. Hebert
Rt. 2, Box 332
Biloxi, MS 39532
(mailing address)

description of formations encountered	from	to
	Kelly, clay	0
white Sand	20	80
Blue Clay	80	200
Grey Sand	200	320

WELL LOCATION:
sec. 33 T. 6 S. R. 9 W.
2 miles N of Nettieville
(distance) (direction) (nearest town)

WELL PURPOSE: home
(home, irrigation, municipal, industrial)

- WELL COMPLETION DATA:
- diameter (Inches) 4 x 2
 - total depth (feet) 320
 - static water level (feet) 40' below top of ground.
 - casing PVC 4" 200' (material) (depth)
4" x 2" (size) If telescope see back.
 - screen 10' PVC 300' (length) (depth to top)
2" (size) PVC .008 (material)
 - pump 1 HP 20 (HP) (yield gpm)
230 (type power)
 - electric log NO (yes or no)
(organization running log)
 - how well bottom plugged back-wash check valve

RECEIVED

APR 9 1986

DRILLERS REMARKS:

Department of Natural Resources
Bureau of Land & Water Resources

If well telescopes please sketch and show depths.

GROUND LEVEL

4" Jd 40
PVC

200 FT


2 1/2" Jd 40
PVC

300 FT

2" x 10 FT
PVC Screen

320 FT

2" PVC
Sand
Shank

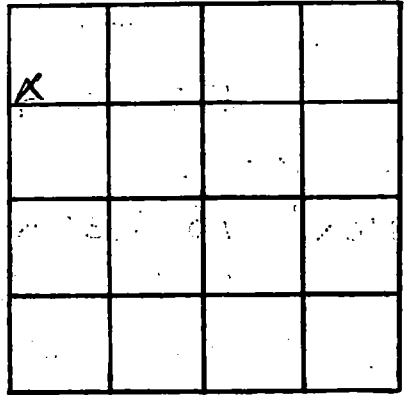

SECTION 33

Please indicate well location X.

ADDITIONAL INFORMATION

If more than one screen,
show locations of each on sketch.