

MISSISSIPPI DEPARTMENT OF NATURAL RESOURCES

Bureau of Land and Water Resources

Southport Mall

P.O. Box 10631

Jackson, Mississippi 39209

WATER WELL DRILLERS LOG

HARRISON
H
2352

12-5 1985 Braden Pump Well Co. Harrison
date well completed firm name county well located

LANDOWNER: John Taylor
342 Sooty Creek Rd.
Bilbo, Miss. 39532
(mailing address)

WELL LOCATION:
sec 36 T 6 S R 10 W
1/2 miles N of Cedar Lake
(distance) (direction) (nearest town)

WELL PURPOSE: Home
(home, irrigation, municipal, industrial)

WELL COMPLETION DATA:

(1) diameter (inches) 2"

(2) total depth (feet) 315

(3) static water level (feet) 25 below top of ground.

(4) casing PVC Total
(material) (depth)
2" (size) If telescope see back.

(5) screen 10 FT 300 FT
(length) (depth to top)
2" PVC .0085" (size) (material)

(6) pump 1 HP 10 (yield gpm)
200V 1φ (type power)

(7) electric log No (yes or no)

(8) how well bottom plugged 2" PVC Sand Shank

description of formations encountered	from	to
Surface	0	6
Sandy Clay layers	6	65
Sand	65	70
White Clay	70	135
Sand	135	140
Blue Clay	140	295
Grey Sand	295	310
Blue Clay	310	315


RECEIVED
APR - 3 1986

Department of Natural Resources
Bureau of Land & Water Resources

DRILLERS REMARKS:
5 FT Tail pipe

If well telescopes please sketch and show depths.

GROUND LEVEL

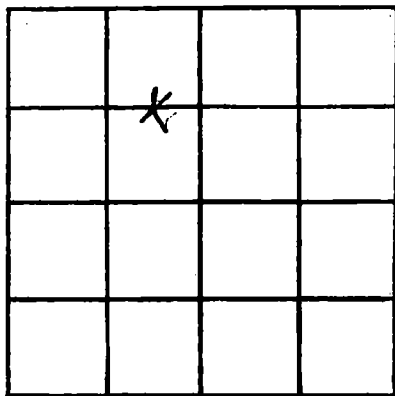

SECTION 36

Please indicate well location X.

ADDITIONAL INFORMATION

If more than one screen, show locations of each on sketch.