

MISSISSIPPI DEPARTMENT OF NATURAL RESOURCES

Bureau of Land and Water Resources

Southport Mall

P.O. Box 10631

Jackson, Mississippi 39209

WATER WELL DRILLERS LOG

Harrison
H
2353

4/19/85 19
date well completed

Lyman Well Co.
firm name

Harrison
county well located

LANDOWNER: Harry Schermer
Schermer
Old Hwy 49
Gulfport, MS 39503
(mailing address)

description of formations encountered	from	to
0-80 Red sand	0	80
80-260 Blue clay & sh	80	260
	260	285

WELL LOCATION:
sec 31 T 6 N R 10 E
7 miles W of Gulfport
(distance) (direction) (nearest town)

WELL PURPOSE: Home
(home, irrigation, municipal, industrial)

- WELL COMPLETION DATA:
- (1) diameter (inches) 2"
 - (2) total depth (feet) 285'
 - (3) static water level (feet) 12 ^{below} _{above} top of ground.
 - (4) casing PVC, 275'
(material) (depth)
2"
(size) if telescope see back.
 - (5) screen 10', 275'
(length) (depth to top)
2", PVC
(size) (material)
 - (6) pump 1, 15
(HP) (yield gpm)
electric
(type power)
 - (7) electric log NO
(yes or no)
NO
(organization running log)
 - (8) how well bottom plugged sand
shark


DRILLERS REMARKS:

RECEIVED
APR 29 1985

Department of Natural Resources
Bureau of Land & Water Resources

If well telescopes please sketch and show depths.

GROUND LEVEL

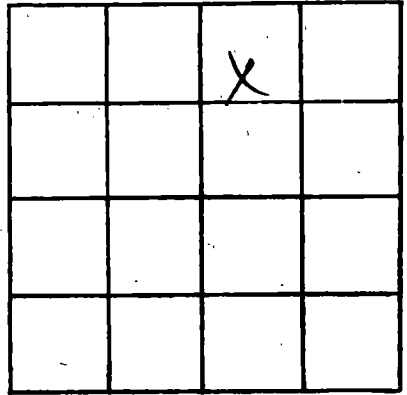

SECTION 31

Please indicate well location X.

ADDITIONAL INFORMATION

If more than one screen,
show locations of each on sketch.