

MISSISSIPPI DEPARTMENT OF NATURAL RESOURCES

Bureau of Land and Water Resources

Southport Mall

P.O. Box 10631

Jackson, Mississippi 39209

WATER WELL DRILLERS LOG

HARRISON
 H
 2354

2-28-86 19
 date well completed

R. Moore
 firm name

HARRISON
 county well located

LANDOWNER: James ARMSTRONG

Description of formations encountered

from to

WOOLMARKED PLANTATION EAST
WOOLMARK RD
BILOXI MS 39532
 (mailing address)

<u>TOP SOIL</u>	<u>0</u>	<u>10</u>
<u>Red Sandstone</u>	<u>10</u>	<u>25</u>
<u>Blue Clay</u>	<u>25</u>	<u>180</u>
<u>FINE SAND</u>	<u>180</u>	<u>200</u>
<u>Blue Clay</u>	<u>200</u>	<u>400</u>
<u>Med Sand</u>	<u>400</u>	<u>440</u>
<u>Coarse Sand</u>	<u>440</u>	<u>460</u>

WELL LOCATION:

sec. 36 T. 6 N. R. 10 E
2 miles E of WOOLMARKED
 (distance) (direction) (nearest town)

WELL PURPOSE:

(Home) Irrigation, municipal, industrial

WELL COMPLETION DATA:

- diameter (inches) 2"
- total depth (feet) 460'
- static water level (feet) 45' below above top of ground.
- casing PVC 460'
 (material) (depth)
 (size) If telescope see back.
- screen 10' 460'
 (length) (depth to top)
2" PVC
 (size) (material)
- pump 1 6
 (HP) (yield gpm)
E
 (type power)
- electric log
 (yes or no)
 (organization running log)
- how well bottom plugged Pusha

RECEIVED


APR 21 1986

Department of Natural Resources
 Bureau of Land & Water Resources

DRILLERS REMARKS:

If well telescopes please sketch and show depths.

GROUND LEVEL

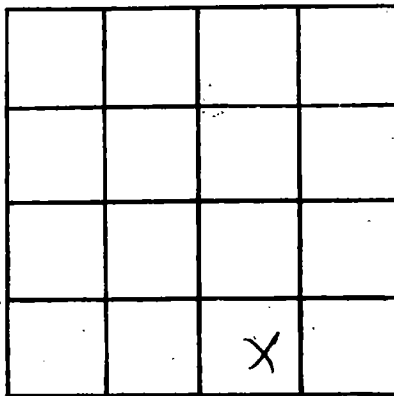

SECTION 3.5

Please indicate well location X.

ADDITIONAL INFORMATION

If more than one screen, show locations of each on sketch.