

MISSISSIPPI DEPARTMENT OF NATURAL RESOURCES

Bureau of Land and Water Resources

Southport Mall

P.O. Box 10631

Jackson, Mississippi 39209

WATER WELL DRILLERS LOG

HARRISON
H
2356

4-3-86 19
date well completed

R Moore
firm name

HARRISON
county well located

LANDOWNER: BLAIN KROHN
KROHN
BIG JOHN RD
Blount, MS
(mailing address)

description of formations encountered	from to	
Red Sand clay	0	20
Co. to clay	20	60
Blue clay	60	300
med sand	300	340

WELL LOCATION:
sec. ~~24~~ 6 N R-10 E
2 1/2 miles N of COAK LAKE
(distance) (direction) (nearest town)

WELL PURPOSE:
(home) Irrigation, municipal, industrial

- WELL COMPLETION DATA:
- (1) diameter (inches) 2"
 - (2) total depth (feet) 340'
 - (3) static water level (feet) 95' below top of ground
 - (4) casing PVC, 340' (depth)
 - (size) If telescope see back.
 - (5) screen 10' (length), 340' (depth to top)
 - (size) 2" (size), PVC (material)
 - (6) pump 1 1/2 (HP), 6 (yield gpm)
 - (type power) E
 - (7) electric log (yes or no)
 - (organization running log)
 - (8) how well bottom plugged Moore

RECEIVED


APR 21 1986

Department of Natural Resources
Bureau of Land & Water Resources

DRILLERS REMARKS:

If well telescopes please sketch and show depths.

GROUND LEVEL

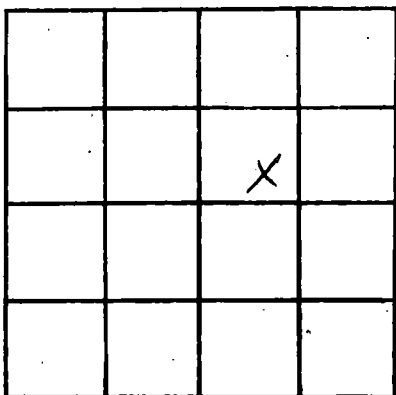

SECTION 24

Please indicate well location X.

ADDITIONAL INFORMATION

If more than one screen, show locations of each on sketch.