

MISSISSIPPI DEPARTMENT OF NATURAL RESOURCES

Bureau of Land and Water Resources

Southport Mall

P.O. Box 10631

Jackson, Mississippi 39209

WATER WELL DRILLERS LOG

HARRISON
H
2357

6/8/85 19__
 date well completed

COASTAL DRILLING & SERVICE CO. Harrison
 firm name county well located

RT. 11, BOX 81

LANDOWNER: El Bayou Water
Cowan Rd.
Biloxi, MS
 (mailing address)

description of formations encountered	from	to
top soil	1	25
red clay	25	200
soft blue clay	200	310
hard blue clay	310	535
fine water sand	535	605
red clay	605	685
hard blue clay	685	710
fine water sand	710	730
good water sand	730	740

WELL LOCATION:
 sec. 22 T. 6 N. R. 10 E. W. 5
Biloxi miles (distance) of (direction) (nearest town)

WELL PURPOSE: home
 (home, irrigation, municipal, industrial)

WELL COMPLETION DATA:

(1) diameter (inches) 4" X 2"

(2) total depth (feet) 740

(3) static water level (feet) 20 (depth) top of ground.

(4) casing pvc (material), 720 (depth)

4" X 2" (size) if telescope see back.

(5) screen 20 (length), 720 (depth to top)

2" (size), pvc (material)

(6) pump 5 (HP), 19 (yield gpm)


elec. (type power)

(7) electric log no (yes or no)

(organization running log)

(8) how well bottom plugged 2" back
wash valve.

DRILLERS REMARKS:

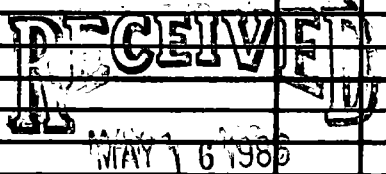

Department of Natural Resources
 Bureau of Land & Water Resources

If well telescopes please sketch and show depths.

GROUND LEVEL


160' 4" pvc casing

580' 2" pvc casing

20' 2" pvc screen

2" back wash valve

If more than one screen, show locations of each on sketch.

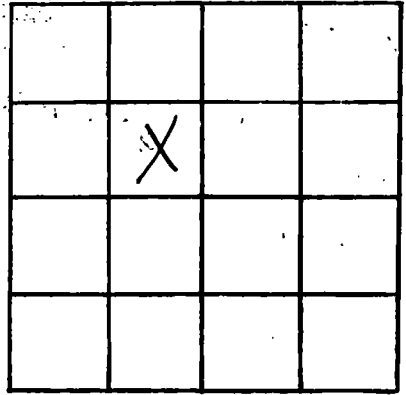

SECTION _____

Please indicate well location X.

ADDITIONAL INFORMATION

Multiple horizontal lines for additional information.