

MISSISSIPPI DEPARTMENT OF NATURAL RESOURCES

Bureau of Land and Water Resources

Southport Mall

P.O. Box 10631

Jackson, Mississippi 39209

WATER WELL DRILLERS LOG

HARRISON
H
2358

COASTAL DRILLING & SERVICE CO. (inc.)
Box name: RT. 11, BOX 81
county well located

11/11/85
date well completed

LANDOWNER: Joleyn Cassidy

11011, MS 39522
encountered

from to

Wilson Rd.

top soil

1 10

Beloxi, MS

red clay

10 80

(mailing address)

soft blue clay

80 195

WELL LOCATION:

thin water sand

195 235

sec. 27 T. 6 N. R. 19 E. S. W.

good water sand

235 245

Wilson Rd. of
(distance) (direction) (nearest town)

WELL PURPOSE: home
(home, irrigation, municipal, industrial)

WELL COMPLETION DATA:

- (1) diameter (inches) 2"
- (2) total depth (feet) 245
- (3) static water level (feet) 20 below top of ground.

- (4) casing pvc, 60' (material) (depth)

(size) If telescope see back.

- (5) screen 10', 235 (length) (depth to top)

2" pvc (size) (material)

- (6) pump 1, 10 (HP) (yield gpm)

plc. (type power)

- (7) electric log no. (yes or no)

(organization running log)

- (8) how well bottom plugged 2" back wash valve.


DRILLERS REMARKS:

RECEIVED
MAY 19 1986

Department of Natural Resources
Bureau of Land & Water Resources

If well telescopes please sketch and show depths.

GROUND LEVEL

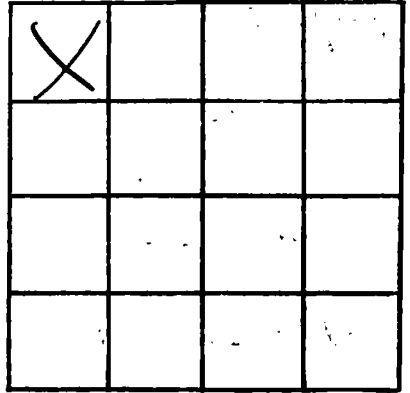

SECTION _____

Please indicate well location X.

ADDITIONAL INFORMATION

If more than one screen,
show locations of each on sketch.