

MISSISSIPPI DEPARTMENT OF NATURAL RESOURCES

Bureau of Land and Water Resources

Southport Mall

P.O. Box 10631

Jackson, Mississippi 39209

WATER WELL DRILLERS LOG

COASTAL DRILLING & SERVICE (signature)

RT. 19, BOX 81

county well located

JACKSON  
H  
2359

11/12/85 19  
date well completed

LANDOWNER: Nancy M. BLOXIE

Bloxie, Ms.

Jouraine rd  
(mailing address)

description of formations encountered

	from	to
top soil	1	3
red clay	3	85
hard blue clay	85	215
fine water sand	215	235
good water sand	235	245

WELL LOCATION:

sec. 33 T. 6 N R. 10 E  
S S W

Woodmark, (distance) miles (direction) of (nearest town)

WELL PURPOSE: home (home, irrigation, municipal, industrial)


WELL COMPLETION DATA:

- (1) diameter (inches) 2"
- (2) total depth (feet) 245
- (3) static water level (feet) 20 below top of ground.
- (4) casing pvc 60 (material), (depth) (size) If telescope see back.
- (5) screen 10 235 (length), (depth to top) (size) pvc (material)
- (6) pump 1 (HP) 11 (yield gpm) Etc. (type power)
- (7) electric log NO (yes or no)

(organization running log)

(8) how well bottom plugged 2" back wash valve.


DRILLERS REMARKS:

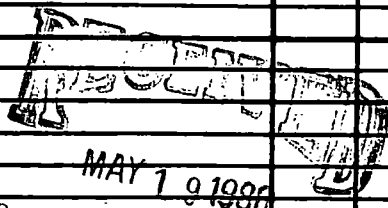

Department of Natural Resources  
Bureau of Land and Water Resources

If well telescopes please sketch and show depths.

GROUND LEVEL

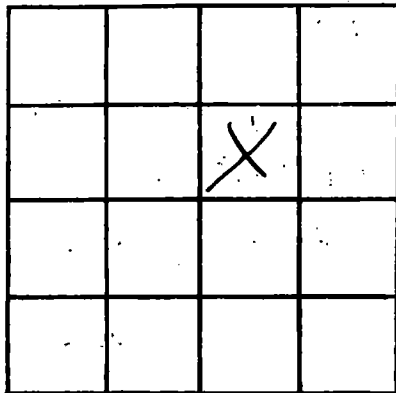

SECTION \_\_\_\_\_

Please indicate well location X.

ADDITIONAL INFORMATION

If more than one screen, show locations of each on sketch.