

MISSISSIPPI DEPARTMENT OF NATURAL RESOURCES

Bureau of Land and Water Resources

Southport Mall

P.O. Box 10631

Jackson, Mississippi 39209

COASTAL DRILLING & SERVICE CO.

RT. 11, BOX 81

BILOXI, MS 39532

Harrison

county well located

HARRISON
4
2360

11/18/85
date well completed

LANDOWNER: R.E. Moody
Rt. 11 Box 640

Biloxi, MS
(mailing address)

WELL LOCATION:
sec. 4 T. 6N R. 10E
S W
Woodmarket
(distance) (direction) (nearest town)

WELL PURPOSE: home
(home, irrigation, municipal, industrial)

WELL COMPLETION DATA:

- (1) diameter (inches) 4" x 2"
- (2) total depth (feet) 580
- (3) static water level (feet) 15 below top of ground.
- (4) casing PVC, 800 (material) (depth)
1 1/4 (size) if telescope see back.
- (5) screen 15' (length), 160 (depth to top)
2' (size), PVC (material)
- (6) pump 1 (HP), 11 (yield gpm)
Etc. (type power)
- (7) electric log NO (yes or no)

(organization running log)

(8) how well bottom plugged 2" back
wash valve.

DRILLERS REMARKS:

description of formations encountered	from	to
top soil	1	10
red clay	10	140
fine water sand	140	150
good water sand	150	160
sat blue clay	160	390
hard blue clay	390	465
red clay	465	560
good water sand	560	580

RECEIVED
MAY 19 1986

Department of Natural Resources
Bureau of Land & Water Resources

If well telescopes please sketch and show depths.

GROUND LEVEL


160' 4" pvc casing

420' 2" pvc casing

15' 2" pvc screen

2" pvc back wash valve

If more than one screen, show locations of each on sketch.

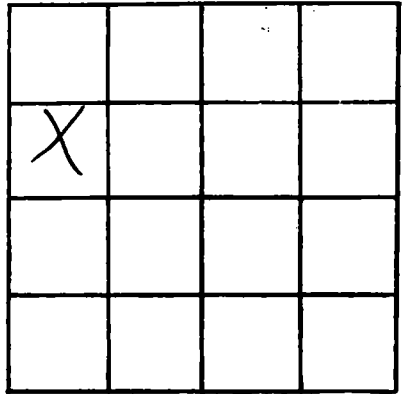

SECTION _____

Please indicate well location X.

ADDITIONAL INFORMATION

Multiple horizontal lines for additional information.